MISSISSIPPI DEPARTMENT OF NATURAL RESOURCES

Bureau of Land and Water Resources

P.O. Box 10631
Jackson, Mississippi 39209

WATER WELL DRILLERS LOG

COUNTY WELL LOCATED: Pearl River

WELL NUMBER: W 2122 | CODED:

DATE WELL COMPLETED: 2-21-89

PERMIT NUMBER: 0-477

NAME OF DRILLING FIRM: Penton Well Serv.

P.O. Box 91 Nicholson, MS.

NAME & MAILING ADDRESS OF LANDOWNER:
Thomas F. Sheffield
605 Briarwood Lane
Picayune, MS. 39466

WELL LOCATION: SEC 14 TOWNSHIP 6 S RANGE 17 W

DISTANCE 0 Miles DIRECTION 0 NEAREST TOWN Picayune

OTHER LANDMARK: Next to P.O. Picayune at Putnam Auto

WELL PURPOSE: Home, Irrigation, Municipal, Industrial, Fish Pond, etc.
Closed Loop

PUMP DATA

PUMP TYPE (Circle One): Submersible, Turbine, Jet, Flowing Well, Other (Describe) _____

POWER TYPE (Circle One): Electric, Tractor, Diesel, Gasoline, Butane, Other (Describe) _____

Pump Capacity (GPM)	No. of Stages	Setting Depth
		FT.

PUMP TEST

Well yielded _____ GPM with a drawdown of _____ ft. after _____ hours of pumping

WELL DATA

Depth	Casing Diameter (In.)	Casing Length (Ft.)
200'	1"	200'

Type of Casing	Hole Depth	Depth to Static Water Level
PVC	200'	Closed Loop

TYPE OF COMPLETION: (Circle One or More): Gravel Packed, Underreamed, Telescoped, Natural Development, Open Hole, Other (Describe) _____

Top of Lap Pipe or Reduction in Casing FEET

IF TELESCOPED OR MORE THAN ONE SCREEN: USE BACK PAGE

LOG DATA

TYPE OF LOG RUN (Circle One): No Log Run, Electric, Gamma Ray, Density, Sonic, Neutron, Other (Describe) _____

Name of Organization Running Log

GEOLOGIC DATA (Office Use Only)

Surface Elev.	Geologic Unit	Unit Thickness	Depth to Top
Subs. SWL	Date	Analysis	Aquifer Test

Driller's Remarks
This Log is for 3 Holes.

SCREEN DATA

Diameter - Inches	Length - Feet	Slot Size - Inches

Screen Type	Depth to Bottom - Feet

RECEIVED
MAR 08 1989
Department of Natural Resources
Bureau of Land & Water Resources

DESCRIPTION OF FORMATIONS ENCOUNTERED	FROM	TO
Clay	0	45
Sand & Gravel	45	95
Blue Clay	95	200

FORMATIONS (Continued)	FROM	TO

IF MORE SPACE IS NEEDED, USE BACK

If well telescopes please
sketch and show depths.

GROUND LEVEL

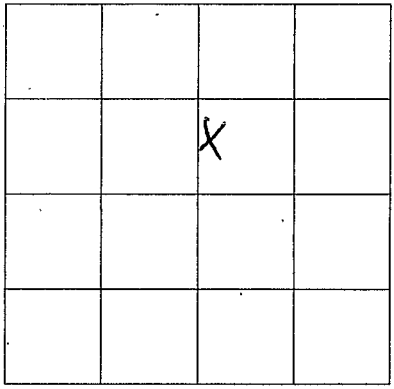

SECTION 14

Please indicate well location X.

ADDITIONAL INFORMATION

If more than one screen,
show location of each on sketch.