Pearl River
X 10
9-15-69

MISSISSIPPI
BOARD OF WATER COMMISSIONERS CODED
416 North State Street
Jackson, Mississippi 39201

WATER WELL DRILLERS LOG

9-15 19 69 Ponton Well Serv Pearl River
date well completed — firm name — county well located

LANDOWNER: Ralph Westbrook
Rt 3 Box 60
Picayune Miss.
(mailing address)

WELL LOCATION:
sec. 8 T 6 N/S R 16 E/W
2 miles (distance) East (direction) of Picayune (nearest town)

WELL PURPOSE: Home
(home, irrigation, municipal, industrial)

WELL COMPLETION DATA: 4½ Drilled
(1) diameter (inches) 2"
(2) total depth (feet) 606
(3) static water level (feet) 8 below ~~above~~ top of ground.
(4) casing Galv (material), 601 (depth),
2" (size) if telescope see back.
(5) screen 5' (length), 601 (depth to top)
.012 2" (size), S. Steel (material)
(6) pump — (HP) — (yield gpm)
— (type power)
(7) electric log NO (yes or no)
(organization running log)
(8) how well bottom plugged BW Valve

DRILLERS REMARKS:

description of formations encountered	from	to
Surface Clay	0	18
Sand	18	65
White Clay	65	90
Blue Clay	90	140
Brown Sand	140	148
Blue Clay	148	270
Grey Sand	270	276
Blue Clay	276	340
Mud	340	348
Blue Clay	348	540
Grey Sand	540	606

OCT 13 1969
MISS. BD. OF WATER COMM.

If well telescopes please sketch and show depths.

GROUND LEVEL

If more than one screen, show locations of each on sketch.

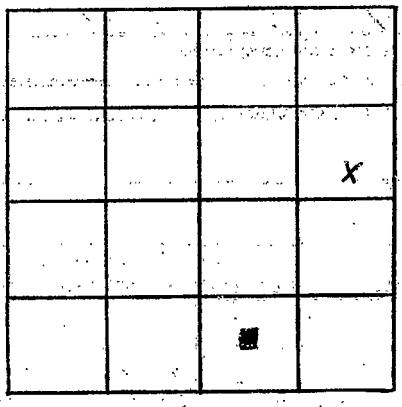

SECTION 8

Please indicate well location X.

ADDITIONAL INFORMATION