Pearl River
X 2026
1-10-77

13V

MISSISSIPPI
BOARD OF WATER COMMISSIONERS
416 North State Street
Jackson, Mississippi 39201

WATER WELL DRILLERS LOG

1-10-77 1977 Bud Lenton & Son Pearl River
date well completed firm name county well located

LANDOWNER: Frank Smith
Carrie Ross
(mailing address)

WELL LOCATION:
sec. 8 T 6 N (S) R 16 E (W)
1½ miles E of Pecayune
(distance) (direction) (nearest town)

WELL PURPOSE: Home
(home, irrigation, municipal, industrial)

WELL COMPLETION DATA:

(1) diameter (inches) 2in
(2) total depth (feet) 205
(3) static water level (feet) 35 below top of ground.
(4) casing PVC (material), 205 (depth),
____ (size) if telescope see back.
(5) screen 10 (length), 205 (depth to top)
2in (size), PVC (material)
(6) pump 1 (HP) 650 (yield gpm) W
electric (type power)
(7) electric log NO (yes or no)
____ (organization running log)
(8) how well bottom plugged Sand Shale

DRILLERS REMARKS:

description of formations encountered	from	to
White Shale	0	12
White Sand	12	65
Blue Shale	65	160
White Sand	160	175
Blue Shale	175	185
Blue Sand	185	213

RECEIVED
APR 15 1977
MISS. BD. OF WATER COMM.

If well telescopes please sketch and show depths.

GROUND LEVEL

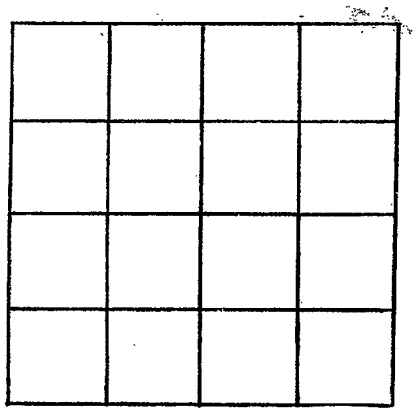

SECTION _____

Please indicate well location X.

ADDITIONAL INFORMATION

If more than one screen, show locations of each on sketch.