PEARL RIVER
X 2102

MISSISSIPPI DEPARTMENT OF NATURAL RESOURCES

Bureau of Land and Water Resources
Southport Mall
P.O. Box 10631
Jackson, Mississippi 39209

WATER WELL DRILLERS LOG

6-3- 1986 PENTON WELL SERV. PEARL RIVER
date well completed — firm name — county well located

LANDOWNER: Bob Helmer
RT. 1 Box 199B
PICAYUNE, MS. 39466
(mailing address)

WELL LOCATION:
sec. 12 T 6 (S) R 16 (W)
5 miles E of PICAYUNE
(distance) (direction) (nearest town)

WELL PURPOSE: HOME
(home, irrigation, municipal, industrial)

WELL COMPLETION DATA:

(1) diameter (inches) 4" x 2"
(2) total depth (feet) 490'
(3) static water level (feet) 40' below ~~above~~ top of ground.
(4) casing PVC (material), 480' (depth), 4x2 (size) if telescope see back.
(5) screen 10' (length), 480' (depth to top), 2" (size), PVC (material)
(6) pump _____ (HP) _____ (yield gpm)
_____ (type power)
(7) electric log NO (yes or no)
_____ (organization running log)
(8) how well bottom plugged BW.

DRILLERS REMARKS:

description of formations encountered	from	to
Clay	0	40
Red Mud	40	140
Clay	140	280
Silt	280	365
Clay	365	430
Sand	430	490

RECEIVED
JUN 25 1986
Department of Natural Resources
Bureau of Land & Water Resources

If well telescopes please sketch and show depths.

GROUND LEVEL

140' 4"

350' 2"

If more than one screen, show locations of each on sketch.

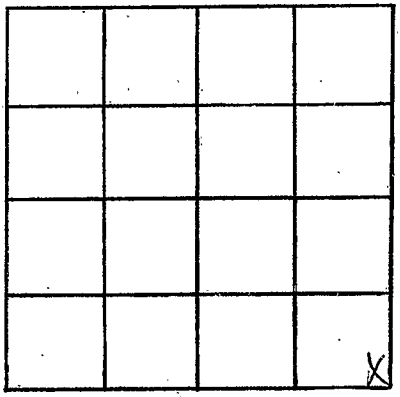

SECTION _____

Please indicate well location X.

ADDITIONAL INFORMATION