MISSISSIPPI DEPARTMENT OF ENVIRONMENTAL QUALITY
Office of Land and Water Resources

P. O. Box 10631
Jackson, MS 39289-0631
WATER WELL DRILLERS LOG

COUNTY WELL LOCATED: Pearl River	
WELL NUMBER: X-2176	CODED:
DATE WELL COMPLETED: 7-14-99	
PERMIT NUMBER: O-514	
NAME OF DRILLING FIRM: Boones Waterwell	

NAME & MAILING ADDRESS OF LANDOWNER
Andrew W Gasper
69 Galatas Lane
Picayune, Ms 39466

WELL LOCATION: SEC 7 TOWNSHIP 6 (N) RANGE 16 (E)

DISTANCE 3 Miles DIRECTION East of NEAREST TOWN Picayune

OTHER LANDMARK

WELL PURPOSE: (Home), Irrigation, Municipal, Industrial, Fish Pond, etc.

PUMP DATA

PUMP TYPE (Circle One): Submersible, Turbine, (Jet) Flowing Well, Other (Describe) _____

POWER TYPE (Circle One): (Electric), Tractor, Diesel, Gasoline, Butane, Other (Describe) _____ H/P 1

Pump Capacity (GPM)	No. of Stages	Setting Depth
5	2	FT.

PUMP TEST

Well yielded _____ GPM with a drawdown of _____ ft. after _____ hours of pumping

WELL DATA

Well Depth	Casing Diameter (In.)	Casing Length (Ft.)
240	2"	230

Type of Casing	Hole Depth	Depth to Static Water Level
Sch 40	240	Flow well

TYPE OF COMPLETION: (Circle One or More): (Gravel Packed), Underreamed, Telescoped, Natural Development, Open Hole, Other (Describe) _____

WELL GROUTED TO A DEPTH OF 5 FEET
Type Grout (circle one): (Cement), Bentonite, or Mix

LOG DATA

TYPE OF LOG RUN (Circle One): No Log Run, Electric, Gamma Ray, Density, Sonic, Neutron, Other (Describe) _____

Name of Organization Running Log

GEOLOGIC DATA (Office Use Only)

Surface Elev.	Geologic Unit	Unit Thickness	Depth to Top
Subs. SWL	Date	Analysis	Aquifer Test

Driller's Remarks

Top of Lap Pipe or Reduction in Casing

IF TELESCOPED OR MORE THAN ONE SCREEN, USE BACK PAGE

SCREEN DATA

Diameter - Inches	Length - Feet	Slot Size - Inches
2"	10 ft	# 8

Screen Type	Depth to Bottom - Feet
Sch 40	

DESCRIPTION OF FORMATIONS ENCOUNTERED	FROM	TO
Sand	0	30
Clay	30	180
Sand	180	240

FORMATIONS (Continued)	FROM	TO

IF MORE SPACE IS NEEDED, USE BACK

JUL 27 2000
Dept. of Environmental Quality
Office of Land & Water Resources

If well telescopes please
sketch and show depths.

GROUND LEVEL

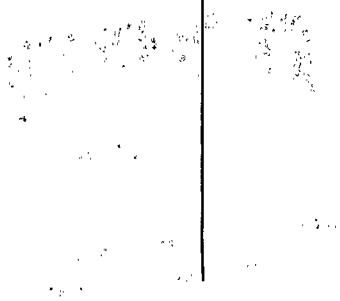

If more than one screen,
show location of each on sketch.

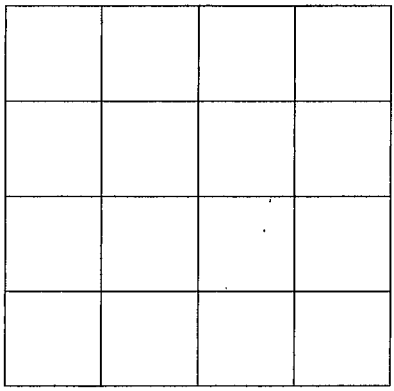

SECTION _____

Please indicate well location X.

ADDITIONAL INFORMATION