Perry
A 53
1-23-72

MISSISSIPPI
BOARD OF WATER COMMISSIONERS
416 North State Street
Jackson, Mississippi 39201

CODED

WATER WELL DRILLERS LOG

Jan 23 19 72 Cochran Drilling Co. Perry
date well completed — firm name — county well located

LANDOWNER: Roy Blackwell
Rt 1
Richton, Miss.
(mailing address)

WELL LOCATION:
sec. 26 T. 5 (N) S R. 11 E (W)
4 miles E of Runnelstown
(distance) (direction) (nearest town)

WELL PURPOSE: Home
(home, irrigation, municipal, industrial)

WELL COMPLETION DATA:

(1) diameter (inches) 2"
(2) total depth (feet) 210'
(3) static water level (feet) 110 (below) above top of ground.
(4) casing PVC, 205,
(material) (depth)
_____ if telescope see back.
(size)
(5) screen 5', 205
(length) (depth to top)
2", PVC
(size) (material)
(6) pump 1 5 1/2
(HP) (yield gpm)
Elect
(type power)
(7) electric log no
(yes or no)
_____
(organization running log)
(8) how well bottom plugged Value

DRILLERS REMARKS: _____

description of formations encountered	from	to
Top soil	0	3
red clay	3	28
Brown clay	28	72
Blue clay	72	117
Gray clay	117	152
Brown clay	152	165
Gray clay	165	210

CODED

MAY 9 1972
MISS. BD. OF WATER COMM.

If well telescopes please sketch and show depths.

GROUND LEVEL

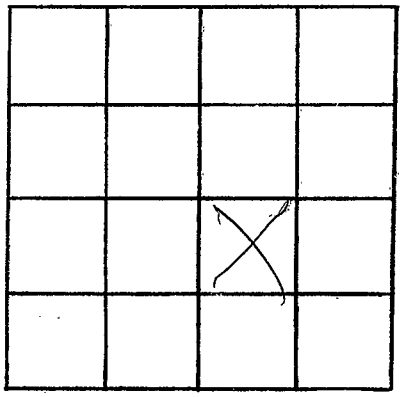

SECTION 26

Please indicate well location X.

ADDITIONAL INFORMATION

If more than one screen, show locations of each on sketch.