

PERRY

MISSISSIPPI BOARD OF WATER COMMISSIONERS

D6

WATER WELL DRILLERS LOG

10-6-60

Date: 10-6, 1960, Driller: Herman Barber County Perry

(Name)

(1) Owner of Land: B. A. CONWAY

(Name)

Rt. # 3 - Richton, Miss

(Address)

(2) Location: NW 1/4, SW 1/4, Sec. 2 T. R.

4 miles South of Sannerstown

(distance)

(direction)

(Nearest Town)

(3) Topography: Hilly

(Hilly)

(Flat)

(Level)

(4) Purpose of Well: Domestic

(Domestic Irrigation, Municipal, Industrial, Other)

Description & Color of Materials
Sand, Clay, Red Clay, Shell, etc.

Thick-
ness
Feet

Depth
Feet

SAND (Red) 30 30
CHALK (Blue) 100
SAND (Blue) 60

Well

190'

Information upon completion of well:

(1) Diameter 2 inches.

(2) Total Depth 190 feet.

(3) Water Level 113 feet below top of ground.

(4) Cased to 190', Size 2"

(5) Screen: Size 2", Length 5'


(6) Were any formations sealed against pollution?

yes, no.

If YES depth of formation.

Why.

Drillers Remarks:

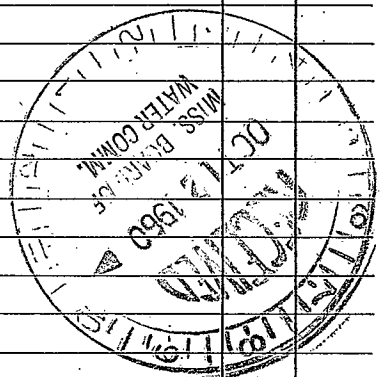

Well No. 3

(Use Back Side)












