Perry
G 2015

MISSISSIPPI DEPARTMENT OF NATURAL RESOURCES
Bureau of Land and Water Resources
Southport Mall
P.O. Box 10631
Jackson, Mississippi 39209

WATER WELL DRILLERS LOG

4

March 9-1982 — date well completed
Cochran Brothers Drilling Ser. — firm name
Perry — county well located

LANDOWNER: Jimmy Nobles
Pt 3 New Augusta
(mailing address)

WELL LOCATION:
sec. 23 T 3 (N) S R 11 E (W)
1/2 (distance) miles E (direction) of Mahned (nearest town)

WELL PURPOSE: home
(home, irrigation, municipal, industrial)

WELL COMPLETION DATA:

(1) diameter (inches) 2"
(2) total depth (feet) 520'
(3) static water level (feet) 2' below above top of ground.
(4) casing PVC (material), 510' (depth),
— (size) if telescope see back.
(5) screen 10' (length), 510' (depth to top)
2" (size), PVC (material)
(6) pump 1/2 (HP) 7 (yield gpm)
Electric (type power)
(7) electric log no (yes or no)
(organization running log)
(8) how well bottom plugged value

DRILLERS REMARKS:

description of formations encountered	from	to
Top Soil	0	2
Gray clay	2	8
Sand	8	28
blue clay	28	110
fine Sand	110	115
blue clay	115	190
blue shale	190	215
blue clay	215	360
blue shale	360	390
blue clay	390	475
Sand	475	520

DEPT. OF NATURAL RESOURCES
BUREAU OF LAND & WATER RESOURCES
APR 12 1982
RECEIVED

If well telescopes please sketch and show depths.

GROUND LEVEL

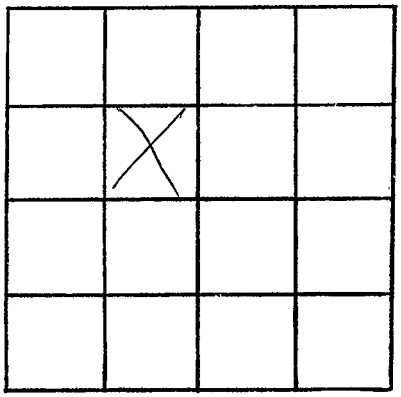

SECTION 23

Please indicate well location X.

ADDITIONAL INFORMATION

If more than one screen, show locations of each on sketch.