Perry
H 2004
7/28/77

130

MISSISSIPPI
BOARD OF WATER COMMISSIONERS
416 North State Street
Jackson, Mississippi 39201

WATER WELL DRILLERS LOG

July 28 (date well completed) 1977 Cochran Drilling Service (firm name) Perry (county well located)

LANDOWNER: Cecile Hilton
Rt 5 New Augusta (mailing address)

WELL LOCATION:
sec. 10 T 3 (N) (S) R 10 (E) (W)
9 (distance) miles NE (direction) of New August (nearest town)

WELL PURPOSE: home (home, irrigation, municipal, industrial)

WELL COMPLETION DATA:
(1) diameter (inches) 2"
(2) total depth (feet) 485'
(3) static water level (feet) _____ below (above) top of ground.
(4) casing PVC (material), 470' (depth), _____ (size) if telescope see back.
(5) screen 15' (length), 470' (depth to top) 2" (size), PVC (material)
(6) pump — (HP) 40 (yield gpm) — (type power)
(7) electric log no (yes or no) _____ (organization running log)
(8) how well bottom plugged solve

DRILLERS REMARKS:

description of formations encountered	from	to
Top soil	0	3
red clay	3	11
red sand	11	19
brown clay	19	24
gray clay	24	40
sand	40	65
gray clay	65	73
white clay	73	84
gray clay	84	105
blue clay	105	285
shale	285	310
blue clay	310	360
sand	360	375
blue clay	375	420
sand	420	485

RECEIVED
AUG 24 1977
MISS. BD. OF WATER COMM

If well telescopes please sketch and show depths.

GROUND LEVEL

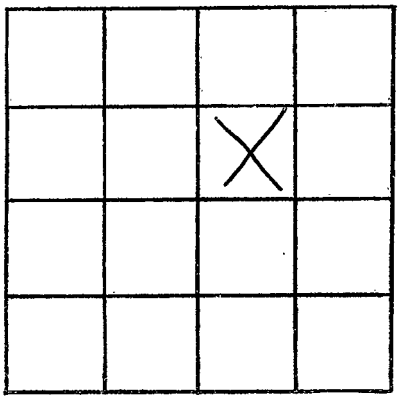

SECTION 10

Please indicate well location X.

ADDITIONAL INFORMATION

If more than one screen, show locations of each on sketch.