Perry
J 42
8-29-73

MISSISSIPPI
BOARD OF WATER COMMISSIONERS
416 North State Street
Jackson, Mississippi 39201

CODED

WATER WELL DRILLERS LOG

August 29 19 73 Cochran Drillers Perry
date well completed — firm name — county well located

LANDOWNER: Paul Johnson
Rt. 1, Beaumont
(mailing address)

WELL LOCATION:
sec. 30 T. 3 (N) S R 9 E (W)
2 miles (N) of Beaumont
(distance) (direction) (nearest town)

WELL PURPOSE: home
(home, irrigation, municipal, industrial)

WELL COMPLETION DATA:
(1) diameter (inches) 2"
(2) total depth (feet) 520'
(3) static water level (feet) _____ below (above) top of ground.
(4) casing PVC (material), 505 (depth), _____ (size) if telescope see back.
(5) screen 15' (length), 505 (depth to top), 2" (size), PVC (material)
(6) pump _____ (HP) 30 (yield gpm)
_____ (type power)
(7) electric log NO (yes or no)
_____ (organization running log)
(8) how well bottom plugged valve

DRILLERS REMARKS:

description of formations encountered	from	to
Top soil	0	2
brown clay	2	9
gray clay	9	25
red clay	25	36
blue clay	36	91
gray clay	91	156
sand	156	163
blue clay	163	317
S hole	317	352
sand	352	383
blue clay	383	481
sand	481	520

CODED

NOV 5 1973

If well telescopes please sketch and show depths.

GROUND LEVEL

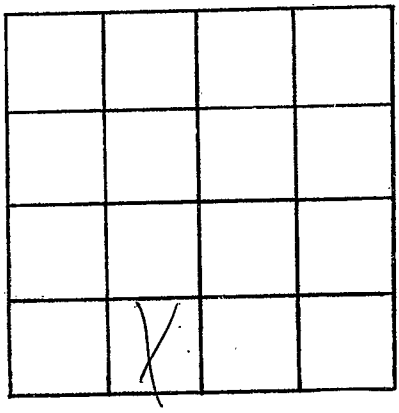

SECTION 5

Please indicate well location X.

ADDITIONAL INFORMATION

If more than one screen, show locations of each on sketch.