MISSISSIPPI DEPARTMENT OF NATURAL RESOURCES

Bureau of Land and Water Resources

P.O. Box 10631
Jackson, Mississippi 39209

WATER WELL DRILLERS LOG

COUNTY WELL LOCATED: Perry	
WELL NUMBER: 1	CODED:
2017	
DATE WELL COMPLETED: 2-28-88	

PERMIT NUMBER	
NAME OF DRILLING FIRM: Cochran Water Well Service	

NAME & MAILING ADDRESS OF LANDOWNER: Annette Womack
Rt 3 Richton

WELL LOCATION: SEC 8 TOWNSHIP 3 (N) S RANGE 9 (E) W

DISTANCE 4 Miles DIRECTION South of NEAREST TOWN Hintonville

OTHER LANDMARK:

WELL PURPOSE: 7 (Home, Irrigation, Municipal, Industrial, Fish Pond, etc.)

PUMP DATA

PUMP TYPE (Circle One): Submersible, Turbine, Jet, Flowing Well, Other (Describe) _____

POWER TYPE (Circle One): Electric, Tractor, Diesel, Gasoline, Butane, Other (Describe) _____ H/P _____

Pump Capacity (GPM)	No. of Stages	Setting Depth
		FT.

PUMP TEST

Well yielded _____ GPM with a drawdown of _____ ft. after _____ hours of pumping

WELL DATA

Well Depth	Casing Diameter (In.)	Casing Length (Ft.)
135'	2	125

Type of Casing	Hole Depth	Depth to Static Water Level
PVC	135'	88'

TYPE OF COMPLETION: (Circle One or More): Gravel Packed, Underreamed, Telescoped, Natural Development, Open Hole, Other (Describe) _____

Top of Lap Pipe or Reduction in Casing: FEET

IF TELESCOPED OR MORE THAN ONE SCREEN: USE BACK PAGE

LOG DATA

TYPE OF LOG RUN (Circle One): No Log Run, Electric, Gamma Ray, Density, Sonic, Neutron, Other (Describe) _____

Name of Organization Running Log

GEOLOGIC DATA (Office Use Only)

Surface Elev.	Geologic Unit	Unit Thickness	Depth to Top
Subs. SWL	Date	Analysis	Aquifer Test

Driller's Remarks

SCREEN DATA

Diameter - Inches	Length - Feet	Slot Size - Inches
2	10	10

Screen Type	Depth to Bottom - Feet
PVC	135

DESCRIPTION OF FORMATIONS ENCOUNTERED	FROM	TO
TOP Soil	0	1
Red Clay	1	5
Brown clay	5	9
blue clay	9	63
Sand + Gravel	63	135

FORMATIONS (Continued)	FROM	TO

RECEIVED NOV 01 1990 Department of Natural Resources Bureau of Land & Water Resources

IF MORE SPACE IS NEEDED, USE BACK

If well telescopes please
sketch and show depths.

GROUND LEVEL

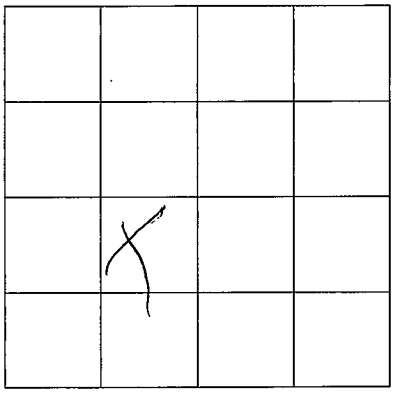

SECTION 8

Please indicate well location X.

ADDITIONAL INFORMATION

If more than one screen,
show location of each on sketch.