MISSISSIPPI DEPARTMENT OF NATURAL RESOURCES

Bureau of Land and Water Resources

P.O. Box 10631
Jackson, Mississippi 39209
WATER WELL DRILLERS LOG

COUNTY WELL LOCATED: ~~Green~~ 2019

WELL NUMBER: Perry J — CODED:

DATE WELL COMPLETED: 9-30-90

PERMIT NUMBER: 0408

NAME OF DRILLING FIRM: Phy Foglo Well Serv.

ADDRESS: Rt 3 Box 53 Ellisville MS 39437-2

NAME & MAILING ADDRESS OF LANDOWNER: Glenn Shows

Rt 1 Box 381

Beaumont MS 39423

WELL LOCATION: SEC 19 TOWNSHIP T3 (N/S) RANGE R8 (E/W) — 1/2 mile West of 15

DISTANCE: 5 Miles DIRECTION: South of NEAREST TOWN: Hexterville

OTHER LANDMARK: on Hwy 15 West Side

WELL PURPOSE: (Home, Irrigation, Municipal, Industrial, Fish Pond, etc.)

PUMP DATA

PUMP TYPE (Circle One): Submersible, Turbine, (Jet), Flowing Well, Other (Describe) _____

POWER TYPE (Circle One): (Electric), Tractor, Diesel, Gasoline, Butane, ~~Other~~ (Describe) _____ H/P _____

Pump Capacity (GPM)	No. of Stages	Setting Depth
5	3	FT.

PUMP TEST: Well yielded 6.4 GPM with a drawdown of 15'2" ft. after 2 hours of pumping

WELL DATA

Well Depth	Casing Diameter (In.)	Casing Length (Ft.)
400'	2"	390'

Type of Casing	Hole Depth	Depth to Static Water Level
PVC	405'	100'

TYPE OF COMPLETION: (Circle One or More): Gravel Packed, Underreamed, Telescoped, Natural Development, Open Hole, Other (Describe) Air Lift

Top of Lap Pipe or Reduction in Casing: _____ FEET

IF TELESCOPED OR MORE THAN ONE SCREEN: USE BACK PAGE

SCREEN DATA

Diameter - Inches	Length - Feet	Slot Size - Inches
2"	10'	#6

Screen Type	Depth to Bottom - Feet
PVC Wrapped Jonsons	400'

LOG DATA

TYPE OF LOG RUN (Circle One): No Log Run, Electric, Gamma Ray, Density, Sonic, Neutron, Other (Describe) _____

Name of Organization Running Log: _____

GEOLOGIC DATA (Office Use Only)

Surface Elev.	Geologic Unit	Unit Thickness	Depth to Top
Subs. SWL	Date	Analysis	Aquifer Test

RECEIVED
FEB 08 1991
Dept. of Environmental Quality
Bureau of Land & Water Resources

Driller's Remarks: _____

DESCRIPTION OF FORMATIONS ENCOUNTERED	FROM	TO
topsoil	0	5
Clay	5	20
"	20	40
"	40	60
"	60	80
"	80	100
Sand	100	108
Clay	108	120
"	120	140
Hardrock clay	140	350

FORMATIONS (Continued)	FROM	TO
Silt	350	370
Med Sand	370	390
Hard Sand	390	400
Salt Sand	400	405

IF MORE SPACE IS NEEDED, USE BACK

If well telescopes please sketch and show depths.

GROUND LEVEL

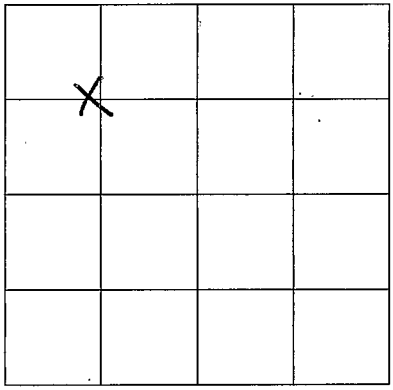

SECTION 17

Please indicate well location X.

ADDITIONAL INFORMATION

If more than one screen, show location of each on sketch.