Perry
R15
11-4-74

MISSISSIPPI
BOARD OF WATER COMMISSIONERS
416 North State Street
Jackson, Mississippi 39201

WATER WELL DRILLERS LOG

CODED

11-4 1974 Pierce Anderson Perry
date well completed firm name county well located

LANDOWNER: Joe McCannis

(mailing address)

WELL LOCATION:
sec. 14 T. 2 (N) (S) R. 10 (E) (W)
16 miles E of Wiggins
(distance) (direction) (nearest town)

WELL PURPOSE: HOME
(home, irrigation, municipal, industrial)

WELL COMPLETION DATA:

(1) diameter (inches) 2"
(2) total depth (feet) 99'
(3) static water level (feet) 73' below ~~above~~ top of ground.
(4) casing Plastic (material) 94' (depth)
_____ (size) if telescope see back.
(5) screen 5' (length), 94' (depth to top)
2" (size), Plastic (material)
(6) pump 1 (HP) 5 (yield gpm)
Elect (type power)
(7) electric log no (yes or no)
(organization running log)
(8) how well bottom plugged Plugged

DRILLERS REMARKS:

description of formations encountered	from	to
Top Soil	0	4
White Clay	4	81
Fine Sand	81	99

CODED

RECEIVED
DEC 6 1974
MISS. BD. OF WATER COMMS

If well telescopes please sketch and show depths.

GROUND LEVEL

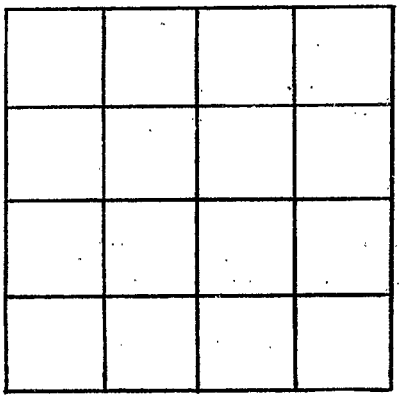

SECTION _____

Please indicate well location X.

ADDITIONAL INFORMATION

If more than one screen, show locations of each on sketch.