PERRY
S 2000
4-9-76

130

MISSISSIPPI
BOARD OF WATER COMMISSIONERS
416 North State Street
Jackson, Mississippi 39201

WATER WELL DRILLERS LOG

4-9 1976 Parnell Anderson Perry
date well completed — firm name — county well located

LANDOWNER: Tommy Johnston
(mailing address)

WELL LOCATION:
sec. 9 T 18 N/S R 9 E/W
14 miles NE of Wiggins
(distance) (direction) (nearest town)

WELL PURPOSE: HOME
(home, irrigation, municipal, industrial)

WELL COMPLETION DATA:
(1) diameter (inches) 2"
(2) total depth (feet) 100'
(3) static water level (feet) 62 below above top of ground.
(4) casing Plastic (material), 95' (depth),
_____ (size) if telescope see back.
(5) screen 5' (length), 95' (depth to top)
2 (size), Plastic (material)
(6) pump 1 (HP) 8 (yield gpm)
Elect (type power)
(7) electric log No (yes or no)
_____ (organization running log)
(8) how well bottom plugged Capped

DRILLERS REMARKS:

description of formations encountered	from	to
Top Soil	0	4
Coarse Sand	4	60
Red Clay	60	72
Coarse Sand	72	100

MAY 5 1976
MISS. BD. OF WATER COMM.

If well telescopes please sketch and show depths.

GROUND LEVEL

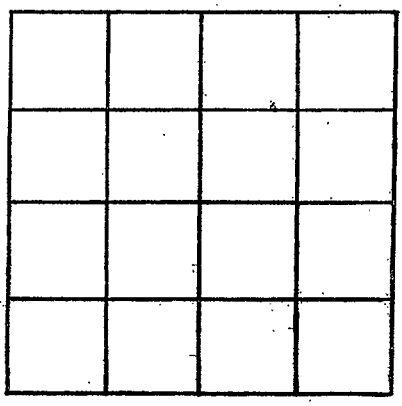

SECTION _____

Please indicate well location X.

ADDITIONAL INFORMATION

If more than one screen, show locations of each on sketch.