Pike
A70
5-1-69

MISSISSIPPI
BOARD OF WATER COMMISSIONERS
416 North State Street
Jackson, Mississippi 39201

WATER WELL DRILLERS LOG

1 May 1969 — date well completed
J. T. Carrington & Son — firm name
Pike — county well located

LANDOWNER: Clinton Johnson
Summit (mailing address)

WELL LOCATION:
sec. 9 T 4 N R 7 E
2½ (distance) miles NW (direction) of Summit (nearest town)

WELL PURPOSE: (home, irrigation, municipal, industrial)

WELL COMPLETION DATA:

(1) diameter (inches) 4
(2) total depth (feet) 87
(3) static water level (feet) 70 below above top of ground.
(4) casing Plastic (material), 87 (depth), 4 (size) if telescope see back.
(5) screen 6 (length), 81 (depth to top), 4 (size), Plastic (material)
(6) pump ½ (HP) 600 (yield gpm) Elec (type power)
(7) electric log _____ (yes or no)
_____ (organization running log)
(8) how well bottom plugged Wood

DRILLERS REMARKS:

description of formations encountered	from	to
Clay	0	15
Clay chalk	15	35
Chalk Sand	35	65
Sand	65	87

JUN 4 - 1969
MISS. BD. OF WATER COMM.

If well telescopes please sketch and show depths.

GROUND LEVEL

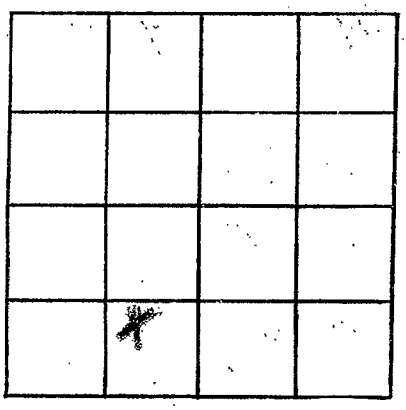

SECTION 9

Please indicate well location X.

ADDITIONAL INFORMATION

If more than one screen, show locations of each on sketch.