Pike
A 72
5-26-69

MISSISSIPPI
BOARD OF WATER COMMISSIONERS
416 North State Street
Jackson, Mississippi 39201

WATER WELL DRILLERS LOG

24 May 1969 — J.T. Cummings & Son — Pike
date well completed — firm name — county well located

LANDOWNER: D.L. Price
Summit
(mailing address)

WELL LOCATION:
sec. 32 T 4 N R 7 E

3 miles (distance) West (direction) of Summit (nearest town)

WELL PURPOSE: Home
(home, irrigation, municipal, industrial)

WELL COMPLETION DATA:

(1) diameter (inches) 4
(2) total depth (feet) 96
(3) static water level (feet) 65 below above top of ground.
(4) casing Plastic (material), 96 (depth),
4 (size) if telescope see back.
(5) screen 6 (length), 90 (depth to top)
4 (size), Plastic (material)
(6) pump 5 (HP) 700 (yield gpm)
Elect. (type power)
(7) electric log _____ (yes or no)
_____ (organization running log)
(8) how well bottom plugged Wood

DRILLERS REMARKS:

description of formations encountered	from	to
Clay	0	6
Chalk	6	20
Sand clay	20	35
Sand & Rock	35	96

JUN 4 - 1969
MISS. BD. OF WATER COMM.

If well telescopes please sketch and show depths.

GROUND LEVEL

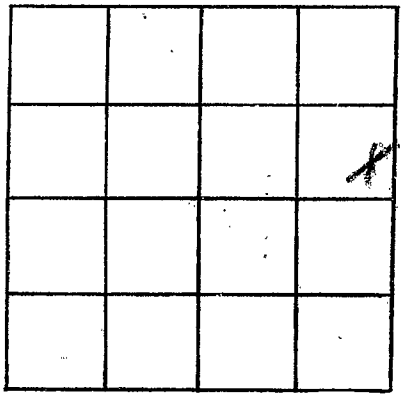

SECTION 32

Please indicate well location X.

ADDITIONAL INFORMATION

If more than one screen, show locations of each on sketch.