PIKE
A200
5-7-85

MISSISSIPPI DEPARTMENT OF NATURAL RESOURCES

Bureau of Land and Water Resources
Southport Mall
P.O. Box 10631
Jackson, Mississippi 39209

WATER WELL DRILLERS LOG

May 7 (date well completed) 19 85 Grenn Water Well (firm name) Pike (county well located)

LANDOWNER: L. J. Coghlan

P.O. Box 53

Summit, Ms.
(mailing address)

WELL LOCATION:
sec. 5 T 4 N/S R 7 E/W

4 (distance) miles NW (direction) of Summit (nearest town)

WELL PURPOSE: home
(home, irrigation, municipal, industrial)

WELL COMPLETION DATA:

(1) diameter (inches) 4

(2) total depth (feet) 123

(3) static water level (feet) 66 below/above top of ground.

(4) casing PVC (material), 113' (depth),
4" (size) if telescope see back.

(5) screen 10 (length), 113' (depth to top)
.010 (size), PVC (material)

(6) pump 1/2 sub (HP) 8 (yield gpm)
electricity (type power)

(7) electric log no (yes or no)

(organization running log)

back wash valve
(8) how well bottom plugged

DRILLERS REMARKS:

description of formations encountered	from	to
Citronelle	1	123

RECEIVED
MAY 17 1985
Department of Natural Resources
Bureau of Land & Water Resources

If well telescopes please sketch and show depths.

GROUND LEVEL

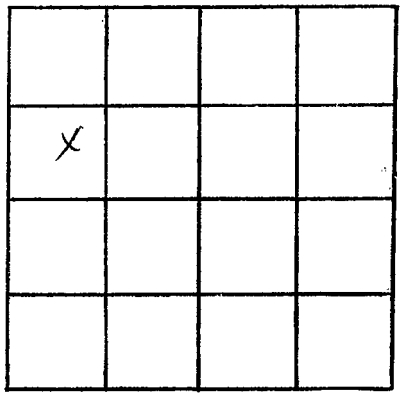

SECTION 5

Please indicate well location X.

ADDITIONAL INFORMATION

If more than one screen, show locations of each on sketch.