Pike
B51
6-68 CODED

MISSISSIPPI
BOARD OF WATER COMMISSIONERS
416 North State Street
Jackson, Mississippi 39201

WATER WELL DRILLERS LOG

6-20 1968 Fitzgerald well Co Pike
date well completed — firm name — county well located

LANDOWNER: Willis Butler

RR Summit, Miss
(mailing address)

WELL LOCATION:
sec. 20 T 4 N/S R 8 E/W
6 miles NE of Summit
(distance) (direction) (nearest town)

WELL PURPOSE: Home
(home, irrigation, municipal, industrial)

WELL COMPLETION DATA:

(1) diameter (inches) 4

(2) total depth (feet) 222

(3) static water level (feet) 100 below/above top of ground.

(4) casing Plastic (material), 196 (depth),
4 (size) if telescope see back.

(5) screen 6' (length), 196' (depth to top)
4" (size), Plastic (material)

(6) pump 1/2 (HP) 15 (yield gpm)
Elec (type power)

(7) electric log No (yes or no)
(organization running log)

(8) how well bottom plugged wood plug

DRILLERS REMARKS:

description of formations encountered	from	to
Red clay	6	20
Red Sand	20	60
White & Blue clay	60	190
Course Sand	190	222

CODED

RECEIVED MISS. BOARD OF WATER COMM.

If well telescopes please sketch and show depths.

GROUND LEVEL

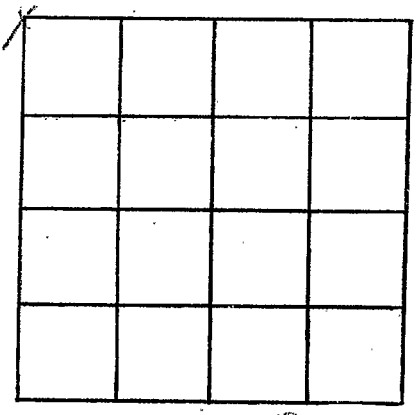

SECTION _____

Please indicate well location X.

ADDITIONAL INFORMATION

If more than one screen, show locations of each on sketch.