

PIKE  
B136  
7/85

MISSISSIPPI DEPARTMENT OF NATURAL RESOURCES  
Bureau of Land and Water Resources  
Southport Mall  
P.O. Box 10631  
Jackson, Mississippi 39209  
WATER WELL DRILLERS LOG

CODED

date well completed 1985 firm name GRANGER DRILLING SER. PIKE county well located

LANDOWNER: SHELL WESTERN  
EXP, NO. 2  
(mailing address)


WELL LOCATION: NW 1/4 NW 1/4 NE 1/4  
sec. 9 T. 4 N. S. R. 8 E. W.

WELL PURPOSE:  
(home, irrigation, municipal, industrial)

WELL COMPLETION DATA:  
(1) diameter (inches) 10 3/4  
(2) total depth (feet) 454  
(3) static water level (feet) 122 below top of ground.  
(4) casing steel, 417 (material), (depth), 10 3/4 (size) if telescope see back.  
(5) screen 20, 434 (length), (depth to top), 6" (size), 304 S.S. (0.016) (material)  
(6) pump 10 (HP), 100 (yield gpm)  
ELECT. (type power)  
(7) electric log Yes (yes or no)  
MGS (organization running log)

description of formations encountered	from	to
TOP SOIL + FILL	0	3
FILL DIRT	3	15
SAND + FINE DIRT	15	42
SAND + pea gravel	42	183
CLAY	183	328
SAND	328	488
CLAY	488	503

CODED

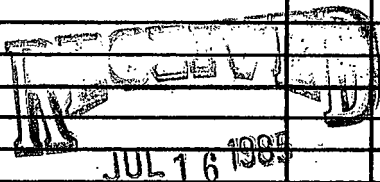


(8) how well bottom plugged BACK  
WASH VALVE + 5 FT. string

DRILLERS REMARKS:

Department of Natural Resources  
Bureau of Land & Water Resources

If well telescopes please sketch and show depths.

GROUND LEVEL

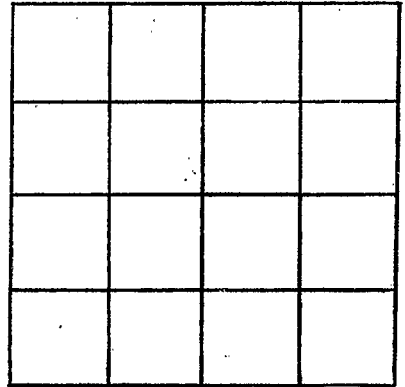

SECTION \_\_\_\_\_

Please indicate well location X.

ADDITIONAL INFORMATION

If more than one screen, show locations of each on sketch.