MISSISSIPPI DEPARTMENT OF NATURAL RESOURCES

Bureau of Land and Water Resources

P.O. Box 10631
Jackson, Mississippi 39209
WATER WELL DRILLERS LOG

COUNTY WELL LOCATED: Pike	
WELL NUMBER: B	CODED:
2069	
DATE WELL COMPLETED: March 1 - 90	

PERMIT NUMBER	
NAME OF DRILLING FIRM: Fitzgerald Well Serv	

NAME & MAILING ADDRESS OF LANDOWNER
Chris Bryant
RR. 1, Summit, Ms.

WELL LOCATION: SEC 12 TOWNSHIP 4 N/S RANGE 8 E/W

DISTANCE 10 Miles DIRECTION E of NEAREST TOWN Summit

OTHER LANDMARK

WELL PURPOSE: Home, Irrigation, Municipal, Industrial, Fish Pond, etc.
Home

PUMP DATA

PUMP TYPE (Circle One): Submersible, Turbine, Jet, Flowing Well, Other (Describe)

POWER TYPE (Circle One): Electric, Tractor, Diesel, Gasoline, Butane, Other (Describe) H/P 1

Pump Capacity (GPM)	No. of Stages	Setting Depth
16	10	130 FT.

PUMP TEST

Well yielded 45 GPM with a drawdown of 2 ft. after 2 hours of pumping

WELL DATA

Well Depth	Casing Diameter (In.)	Casing Length (Ft.)
155	4	145

Type of Casing	Hole Depth	Depth to Static Water Level
PVC	158	90

TYPE OF COMPLETION: (Circle One or More): Gravel Packed, Underreamed, Telescoped, Natural Development, Open Hole, Other (Describe)

Top of Lap Pipe or Reduction in Casing FEET

IF TELESCOPED OR MORE THAN ONE SCREEN: USE BACK PAGE

LOG DATA

TYPE OF LOG RUN (Circle One): No Log Run, Electric, Gamma Ray, Density, Sonic, Neutron, Other (Describe)

Name of Organization Running Log

GEOLOGIC DATA (Office Use Only)

Surface Elev.	Geologic Unit	Unit Thickness	Depth to Top
Subs. SWL	Date	Analysis	Aquifer Test

Driller's Remarks

SCREEN DATA

Diameter - Inches	Length - Feet	Slot Size - Inches
4	10	1014

Screen Type	Depth to Bottom - Feet
PVC	155

DESCRIPTION OF FORMATIONS ENCOUNTERED	FROM	TO	FORMATIONS (Continued)	FROM	TO
Red Clay	0	20			
Red Sand	20	140			
Coarse Sand & gravel	140	155			
			IF MORE SPACE IS NEEDED, USE BACK		

RECEIVED
APR 06 1990
Department of Natural Resources
Bureau of Land & Water Resources

If well telescopes please
sketch and show depths.

GROUND LEVEL

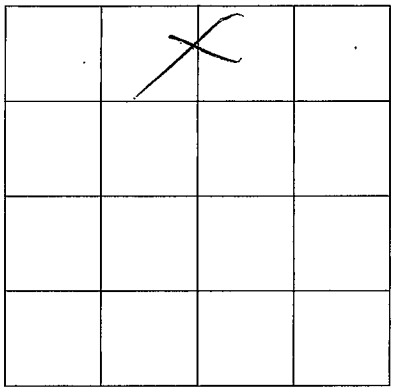

SECTION 12

Please indicate well location X.

ADDITIONAL INFORMATION

If more than one screen,
show location of each on sketch.