MISSISSIPPI DEPARTMENT OF ENVIRONMENTAL QUALITY
Office of Land and Water Resources

P. O. Box 10631
Jackson, MS 39289-0631
WATER WELL DRILLERS LOG

COUNTY WELL LOCATED: Pike	
WELL NUMBER: B 2106	CODED:
DATE WELL COMPLETED: 3-2-00	
PERMIT NUMBER:	
NAME OF DRILLING FIRM: Fitzgerald Well Service	

NAME & MAILING ADDRESS OF LANDOWNER
James Jackson
Hwy 570 Summit

WELL LOCATION: SEC 31 TOWNSHIP 4 (N) S RANGE 8 (E) W

DISTANCE 2 Miles DIRECTION N of NEAREST TOWN McComb

OTHER LANDMARK

WELL PURPOSE: (Home) Irrigation, Municipal, Industrial, (Fish Pond) etc.

PUMP DATA

PUMP TYPE (Circle One): (Submersible) Turbine, Jet, Flowing Well, Other (Describe) ____

POWER TYPE (Circle One): (Electric) Tractor, Diesel, Gasoline, Butane, Other (Describe) ____ H/P 1

Pump Capacity (GPM)	No. of Stages	Setting Depth
20	8	70' FT.

PUMP TEST

Well yielded ____ GPM with a drawdown of ____ ft. after ____ hours of pumping

WELL DATA

Well Depth	Casing Diameter (In.)	Casing Length (Ft.)
80	4"	60'

Type of Casing	Hole Depth	Depth to Static Water Level
PVC	80'	36'

TYPE OF COMPLETION: (Circle One or More): (Gravel Packed) Underreamed, Telescoped, Natural Development, Open Hole, Other (Describe) ____

WELL GROUTED TO A DEPTH OF 10 FEET
Type Grout (circle one): Cement, Bentonite, (or Mix)

LOG DATA

TYPE OF LOG RUN (Circle One): No Log Run, Electric, Gamma Ray, Density, Sonic, Neutron, Other (Describe) ____

Name of Organization Running Log

GEOLOGIC DATA (Office Use Only)

Surface Elev.	Geologic Unit	Unit Thickness	Depth to Top
Subs. SWL	Date	Analysis	Aquifer Test

Driller's Remarks

SCREEN DATA

Diameter - Inches	Length - Feet	Slot Size - Inches
4"	20	012/010

Screen Type	Depth to Bottom - Feet
PVC	80'

Top of Lap Pipe or Reduction in Casing FEET

IF TELESCOPED OR MORE THAN ONE SCREEN: USE BACK PAGE

DESCRIPTION OF FORMATIONS ENCOUNTERED	FROM	TO	FORMATIONS (Continued)	FROM	TO
Top Soil	0	5			
Clay	5	10			
Sand & gravel	10	40			
Clay	40	50			
Couse Sand	50	80			
			IF MORE SPACE IS NEEDED, USE BACK		

REC'D JUN 21 2001

If well telescopes please
sketch and show depths.

GROUND LEVEL

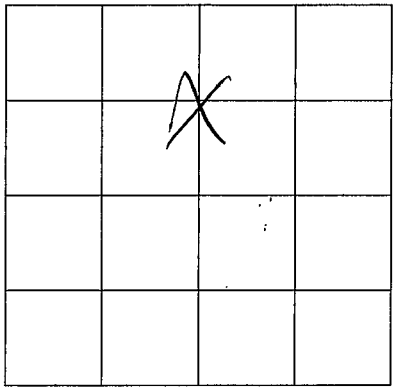

SECTION 31

Please indicate well location X.

ADDITIONAL INFORMATION

If more than one screen,
show location of each on sketch.