Pike
C 65
10-2-72

MISSISSIPPI
BOARD OF WATER COMMISSIONERS
416 North State Street
Jackson, Mississippi 39201

CODED

WATER WELL DRILLERS LOG

Oct. 1972 J.T. Connaughton Pike
date well completed — firm name — county well located

LANDOWNER: Willie Lee Conerly

(mailing address)

WELL LOCATION:
sec. 18 T 4 N/S R 9 E/W
1 miles W (direction) of Fernwood (nearest town)

WELL PURPOSE: home, irrigation, municipal, industrial

WELL COMPLETION DATA:

(1) diameter (inches) 4
(2) total depth (feet) 176
(3) static water level (feet) 120 below/above top of ground.
(4) casing Pl (material), 170 (depth), ____ (size) if telescope see back.
(5) screen 6 (length), 170 (depth to top), 4 (size), Pl (material)
(6) pump 5 (HP) 8 (yield gpm) Elect (type power)
(7) electric log ____ (yes or no)
(organization running log)
(8) how well bottom plugged Wood

DRILLERS REMARKS:

description of formations encountered	from	to
Clay	0	25
Sand Chalk	25	60
Sand Chalk	60	75
Chalk	75	130
Sand	130	176

CODED

DEC 30 1972

If well telescopes please sketch and show depths.

GROUND LEVEL

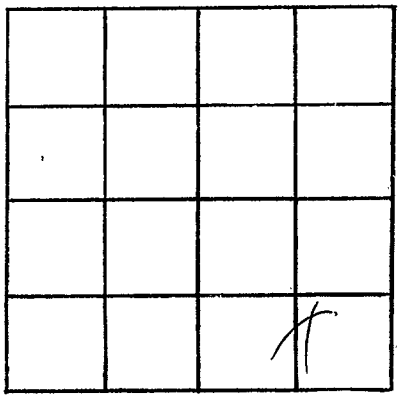

SECTION 18

Please indicate well location X.

ADDITIONAL INFORMATION

If more than one screen, show locations of each on sketch.