C 73
PIKE
7-18-73

MISSISSIPPI
BOARD OF WATER COMMISSIONERS
416 North State Street
Jackson, Mississippi 39201

CODED

WATER WELL DRILLERS LOG

7-18 19 73 Fitzgerald well Co Pike
date well completed — firm name — county well located

LANDOWNER: Felders Camp Ground
RR 2 Summit Miss
(mailing address)

WELL LOCATION:
sec. 17 T 4 (N) S R 9 (E) W
9 (distance) miles E (direction) of Summit (nearest town)

WELL PURPOSE: Home
(home, irrigation, municipal, industrial)

WELL COMPLETION DATA:

2 (1) diameter (inches) 4/4
(2) total depth (feet) 64 ~~74~~
(3) static water level (feet) 6 below above top of ground. 10
(4) casing 4/4 (material), 56/66 (depth),
4/4 (size) if telescope see back.
(5) screen 8/8 (length), 56/66 (depth to top)
4/4 (size), Plastic/Plastic (material)
(6) pump 1/1 (HP) 20/20 (yield gpm)
Elec/Elec (type power)
(7) electric log No/No (yes or no)
(organization running log)
(8) how well bottom plugged 4x2 Sshoe/4x2 Sshoe

DRILLERS REMARKS:

description of formations encountered	from	to
Red Clay	0	10/15
Coarse Sand	10/15	64/74

AUG 15 1973

If well telescopes please sketch and show depths.

GROUND LEVEL

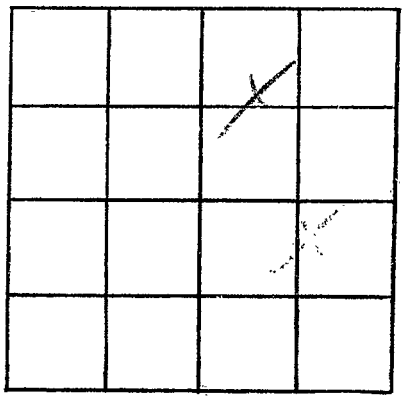

SECTION 17

Please indicate well location X.

ADDITIONAL INFORMATION

If more than one screen, show locations of each on sketch.