PIKE

C 2031

9-18-78

MISSISSIPPI
BOARD OF WATER COMMISSIONERS
416 North State Street
Jackson, Mississippi 39201

WATER WELL DRILLERS LOG

9-18 1978 F. Smith Well Co. Pike
date well completed — firm name — county well located

LANDOWNER: Hennon Albritter

RR. Jayess MS
(mailing address)

WELL LOCATION:
sec. 34 T. 4 N/S R. 9 E/W

2 miles S of Puckett
(distance) (direction) (nearest town)

WELL PURPOSE: Home
(home, irrigation, municipal, industrial)

WELL COMPLETION DATA:

(1) diameter (inches) 4

(2) total depth (feet) 114

(3) static water level (feet) 55 below ~~above~~ top of ground.

(4) casing PVC (material), 106 (depth),
4 (size) if telescope see back.

(5) screen 8 (length), 106 (depth to top)
4 (size), PVC (material)

(6) pump 1/2 (HP) no (yield gpm)
Elec (type power)

(7) electric log ~~yes or no~~ no
(organization running log)

(8) how well bottom plugged Solid

DRILLERS REMARKS:

description of formations encountered	from	to
Red Clay	0	20
Red Sand	20	104
Green Red Sand	104	114

RECEIVED
OCT 4 1978
MISS. BD. OF WATER COMM.

If well telescopes please sketch and show depths.

GROUND LEVEL

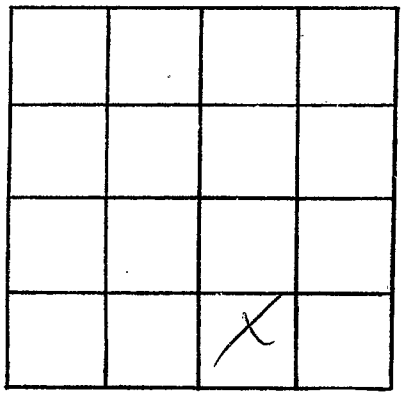

SECTION 34

Please indicate well location X.

ADDITIONAL INFORMATION

If more than one screen, show locations of each on sketch.