MISSISSIPPI DEPARTMENT OF NATURAL RESOURCES

Bureau of Land and Water Resources

P.O. Box 10631
Jackson, Mississippi 39209
WATER WELL DRILLERS LOG

COUNTY WELL LOCATED	Pike
WELL NUMBER	C
CODED	
	2107
DATE WELL COMPLETED	Feb 6 - 90
PERMIT NUMBER	
NAME OF DRILLING FIRM	Fitzgerald Well Serv

NAME & MAILING ADDRESS OF LANDOWNER: Brenda Ingraham, R-R. Jayes Ms.

WELL LOCATION: SEC	TOWNSHIP	RANGE
14	4 N/S	9 E/W

DISTANCE	DIRECTION	NEAREST TOWN
3 Miles	NE	of Brookhaven

OTHER LANDMARK:

WELL PURPOSE: Home, Irrigation, Municipal, Industrial, Fish Pond, etc.: Home

PUMP DATA

PUMP TYPE (Circle One): Submersible, Turbine, Jet, Flowing Well, Other (Describe) ____

POWER TYPE (Circle One): Electric, Tractor, Diesel, Gasoline, Butane, Other (Describe) ____ H/P ____

Pump Capacity (GPM)	No. of Stages	Setting Depth
16	10	130 FT.

PUMP TEST

Well yielded 20 GPM with a drawdown of 3 ft. after 2 hours of pumping

WELL DATA

Well Depth	Casing Diameter (In.)	Casing Length (Ft.)
141	4	131

Type of Casing	Hole Depth	Depth to Static Water Level
PVC	141	91

TYPE OF COMPLETION: (Circle One or More): Gravel Packed, Underreamed, Telescoped, Natural Development, Open Hole, Other (Describe) ____

Top of Lap Pipe or Reduction in Casing: FEET

IF TELESCOPED OR MORE THAN ONE SCREEN: USE BACK PAGE

LOG DATA

TYPE OF LOG RUN (Circle One): Electric, Gamma Ray, Density, Sonic, Neutron, No Log Run, Other (Describe) ____

Name of Organization Running Log:

GEOLOGIC DATA (Office Use Only)

Surface Elev.	Geologic Unit	Unit Thickness	Depth to Top
Subs. SWL	Date	Analysis	Aquifer Test

Driller's Remarks:

SCREEN DATA

Diameter - Inches	Length - Feet	Slot Size - Inches
4	10	1014

Screen Type	Depth to Bottom - Feet
PVC	141

DESCRIPTION OF FORMATIONS ENCOUNTERED	FROM	TO
Red Clay	0	20
Red Sand	20	75
Red Gravel	75	90
Fine Sand	90	128
Course Sand & gravel	128	141

FORMATIONS (Continued)	FROM	TO

IF MORE SPACE IS NEEDED, USE BACK

RECEIVED FEB 15 1990 Department of Natural Resources Bureau of Land & Water Resources

If well telescopes please
sketch and show depths.

GROUND LEVEL

If more than one screen,
show location of each on sketch.

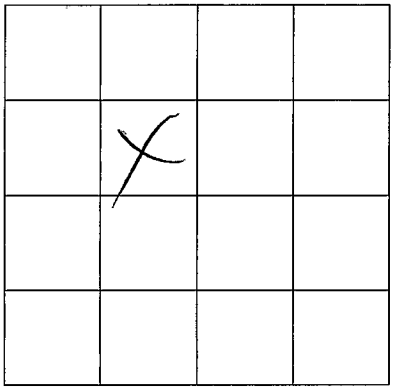

SECTION 14

Please indicate well location X.

ADDITIONAL INFORMATION