

PIKE
 D34^{DED}
 10-6-64

MISSISSIPPI BOARD OF WATER COMMISSIONERS

WATER WELL DRILLERS LOG **CODED**

Date: 10-6, 1964, Driller: Chester Reeves County Pike
 (Name)


(1) Owner of Land (Name) <u>J. D. McKailey</u> <u>M. Camb.</u> (Address)	Description & Color of Materials (Sand, Clay, Red Clay, Shell, etc.)	Thick- ness Feet	Depth Feet
	<u>Red clay</u>	<u>20</u>	<u>20</u>
	<u>Red sand</u>	<u>40</u>	<u>60</u>
(2) Location: <u>1/4</u> , <u>1/4</u> , Sec. <u>20</u> <u>T3R7</u> <u>4</u> miles <u>west</u> of <u>M. Camb.</u> (distance) (direction) (Nearest Town)	<u>Sand & gravel</u>	<u>10</u>	<u>70</u>
	<u>Red clay</u>	<u>10</u>	<u>80</u>
(3) Topography: <u>Hilly</u> (Hilly) (Flat) (Level)	<u>Red sandy sand</u>	<u>20</u>	<u>100</u>
(4) Purpose of Well: <u>Domestic</u> (Domestic Irrigation Municipal, Industrial, Other)	<u>clean sand of small gravel</u>	<u>16</u>	<u>116</u>

Information upon completion of well:

- (1) Diameter 4 inches.
- (2) Total Depth 116 feet.
- (3) Water Level 70 feet below top of ground.
- (4) Cased to bottom Size 4"
- (5) Screen: Size 4", Length 7'
- (6) Were any formations sealed against pollution?
 yes, no.

If YES depth of formation _____
 Why _____
 Drillers Remarks: good well
Bad

CODED

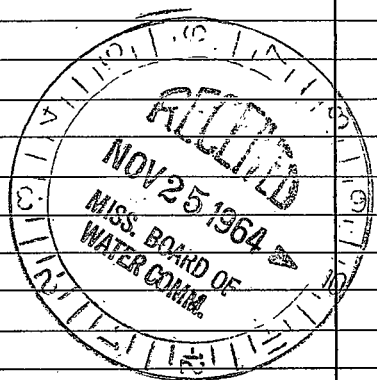

REEVES WELL & PUMP CO
 P. O. BOX 71 -- PHONE 684-1451
 McCOMB, MISS.

(Use Back Side)

Well No.












