

PIKE

MISSISSIPPI BOARD OF WATER COMMISSIONERS

D36

9-2-65 CODED

WATER WELL DRILLERS LOG

CODED

Date: 9-2, 1965, Driller: Chester Kern, County Pike (Name)

(1) Owner of Land: T.D. Magruder  
 (Name)  
 M.C. Lamb  
 (Address)

(2) Location: 1/4, 1/4, Sec. 24 T 3 R 7  
 1 miles south of McLamb  
 (distance) (direction) (Nearest Town)

(3) Topography: Hilly  
 (Hilly) (Flat) (Level)

(4) Purpose of Well: Cattle Plant  
 (Domestic Irrigation  
 Municipal, Industrial, Other)

Description & Color of Materials Sand, Clay, Red Clay, Shell, etc.	Thick- ness Feet	Depth Feet
Soft clay	10	10
Red sand		
Gravel	52	62
gravel & sand	15	77

Information upon completion of well:

(1) Diameter 4 inches.

(2) Total Depth 77 feet.

(3) Water Level 40 feet below top of ground.

(4) Cased to Bottom Size 4

(5) Screen: Size 4", Length 7'


(6) Were any formations sealed against pollution?  
 yes,  no.

CODED

If YES depth of formation \_\_\_\_\_

Why \_\_\_\_\_

Drillers Remarks: New location

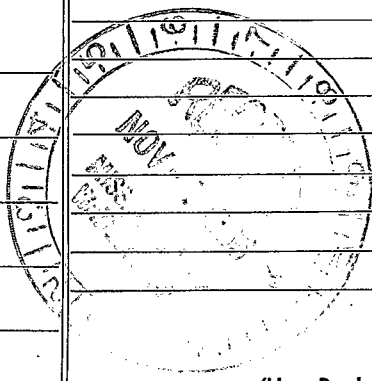

(Use Back Side)

Well No.




