Pike
D 2017
4/22/77

MISSISSIPPI
BOARD OF WATER COMMISSIONERS
416 North State Street
14H Jackson, Mississippi 39201

WATER WELL DRILLERS LOG

4-22 19 77 Fitzwell well Pike
date well completed — firm name — county well located

LANDOWNER: Sam Daniels

R.R. McComb
(mailing address)

WELL LOCATION:
sec. 21 T. 3 (N) S R. 7 (E) W

3 (distance) miles W (direction) of McComb (nearest town)

WELL PURPOSE: Home
(home, irrigation, municipal, industrial)

WELL COMPLETION DATA:

(1) diameter (inches) 4

(2) total depth (feet) 115

(3) static water level (feet) 76 below above top of ground.

(4) casing PVC (material), 107 (depth),
4 (size) If telescope see back.

(5) screen 8 (length), 107 (depth to top)
4 (size), PVC (material)

(6) pump 3/4 (HP) 15 (yield gpm)
Ele (type power)

(7) electric log no (yes or no)
(organization running log)

(8) how well bottom plugged Sand Plug

DRILLERS REMARKS:

description of formations encountered	from	to
Red Clay	0	20
Red gravel	20	100
Coarse Sand & gravel	100	115

RECEIVED
JUL 5 - 1977
MISS. BD. OF WATER COMM.

If well telescopes please sketch and show depths.

GROUND LEVEL

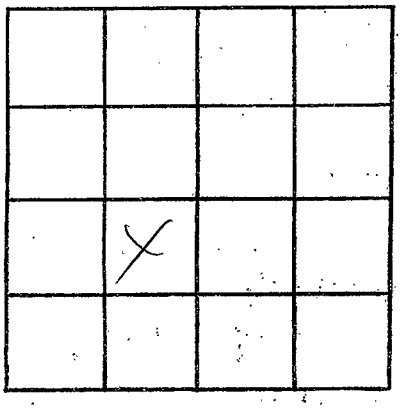

SECTION 21

Please indicate well location X.

ADDITIONAL INFORMATION

If more than one screen, show locations of each on sketch.