Pike
D 2027
9-10-77

14H

MISSISSIPPI
BOARD OF WATER COMMISSIONERS
416 North State Street
Jackson, Mississippi 39201

WATER WELL DRILLERS LOG

9-10 1977 Fitzgerald Well Service Pike
date well completed — firm name — county well located

LANDOWNER: Jim McHale
R.R. McComb
(mailing address)

WELL LOCATION:
sec. 38 T. 3 (N/S) R. 2 (E/W)
3 miles W of McComb
(distance) (direction) (nearest town)

WELL PURPOSE: Home
(home, irrigation, municipal, industrial)

WELL COMPLETION DATA:

(1) diameter (inches) 4
(2) total depth (feet) 133
(3) static water level (feet) 80 below ~~above~~ top of ground.
(4) casing PVC (material), 125 (depth),
4 (size) if telescope see back.
(5) screen 8 (length), 125 (depth to top)
4 (size), PVC (material)
(6) pump 3/4 (HP) 15 (yield gpm)
Elec (type power)
(7) electric log no (yes or no)
(organization running log)
(8) how well bottom plugged Sand Flush

DRILLERS REMARKS:

description of formations encountered	from	to
Red Clay	0	20
Red Sand	20	80
Red gravel	80	120
Coarse Sand & gravel	120	133

RECEIVED
OCT 31 1977
MISS. BD. OF WATER COMM

If well telescopes please sketch and show depths.

GROUND LEVEL

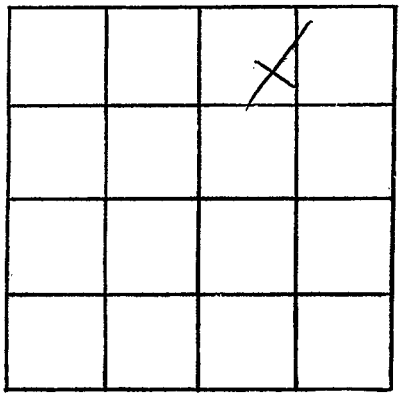

SECTION 28

Please indicate well location X.

ADDITIONAL INFORMATION

If more than one screen, show locations of each on sketch.