MISSISSIPPI DEPARTMENT OF NATURAL RESOURCES

Bureau of Land and Water Resources

P.O. Box 10631
Jackson, Mississippi 39209

WATER WELL DRILLERS LOG

COUNTY WELL LOCATED: Pike	
WELL NUMBER: 4	CODED:
D 2031	
DATE WELL COMPLETED: Aug 2-89	

PERMIT NUMBER	
NAME OF DRILLING FIRM: FITZGERALD WELL SERV	

NAME & MAILING ADDRESS OF LANDOWNER: City of McComb, MS

4th Police Dept.

WELL LOCATION: SEC 12 TOWNSHIP 3 N/S RANGE 7 E/W

DISTANCE: Inside DIRECTION: NEAREST TOWN: McComb

OTHER LANDMARK:

WELL PURPOSE: Home, Irrigation, Municipal, Industrial, Fish Pond, etc.: monitor

PUMP DATA

PUMP TYPE (Circle One): Submersible, Turbine, Jet, Flowing Well, Other (Describe): BAILER

POWER TYPE (Circle One): Electric, Tractor, Diesel, Gasoline, Butane, Other (Describe): HAND

Pump Capacity (GPM)	No. of Stages	Setting Depth
		FT.

PUMP TEST

Well yielded 3 GPM with a drawdown of 4 ft. after 2 hours of pumping

WELL DATA

Well Depth	Casing Diameter (In.)	Casing Length (Ft.)
60	4	5

Type of Casing	Hole Depth	Depth to Static Water Level
PVC	60	45'

TYPE OF COMPLETION: (Circle One or More): Gravel Packed, Underreamed, Telescoped, Natural Development, Open Hole, Other (Describe)

Top of Lap Pipe or Reduction in Casing: FEET

IF TELESCOPED OR MORE THAN ONE SCREEN: USE BACK PAGE

LOG DATA

TYPE OF LOG RUN (Circle One): Electric, Gamma Ray, Density, Sonic, Neutron, Other (Describe) No Log Run

Name of Organization Running Log

GEOLOGIC DATA (Office Use Only)

Surface Elev.	Geologic Unit	Unit Thickness	Depth to Top
Subs. SWL	Date	Analysis	Aquifer Test

Driller's Remarks

RECEIVED
SEP 12 1989
Department of Natural Resources
Bureau of Land & Water Resources

SCREEN DATA

Diameter - Inches	Length - Feet	Slot Size - Inches
4	55	.014

Screen Type	Depth to Bottom - Feet
PVC	60

DESCRIPTION OF FORMATIONS ENCOUNTERED	FROM	TO	FORMATIONS (Continued)	FROM	TO
Red Clay	0	20			
Course Sand	20	40			
Sand & gravel	40	55			
Fine Sand	55	60			
			IF MORE SPACE IS NEEDED, USE BACK		

If well telescopes please
sketch and show depths.

GROUND LEVEL

 

If more than one screen,
show location of each on sketch.

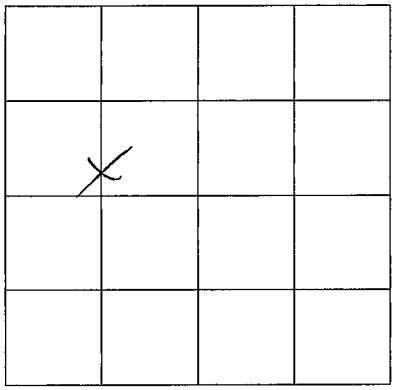

SECTION 12

Please indicate well location X.

ADDITIONAL INFORMATION