MISSISSIPPI DEPARTMENT OF ENVIRONMENTAL QUALITY
Office of Land and Water Resources

P. O. Box 10631
Jackson, MS 39289-0631
WATER WELL DRILLERS LOG

COUNTY WELL LOCATED	Pike
WELL NUMBER	D
CODED	
	2081
DATE WELL COMPLETED	October 8-92
PERMIT NUMBER	
NAME OF DRILLING FIRM	FITZGERALD Well SERV

NAME & MAILING ADDRESS OF LANDOWNER
H. B. McKnight.
RR. 3 McComb, Miss.

WELL LOCATION: SEC 30 TOWNSHIP 3 N/S RANGE 7 E/W

DISTANCE 2 Miles DIRECTION W of NEAREST TOWN McComb

OTHER LANDMARK

WELL PURPOSE: Home, Irrigation, Municipal, Industrial, Fish Pond, etc.
Chicken House

PUMP DATA

PUMP TYPE (Circle One): Submersible, Turbine, Jet, Flowing Well, Other (Describe)

POWER TYPE (Circle One): Electric, Tractor, Diesel, Gasoline, Butane, Other (Describe) H/P 12

Pump Capacity (GPM)	No. of Stages	Setting Depth
20	10	100 FT.

PUMP TEST

Well yielded 40 GPM with a drawdown of 3 ft. after 2 hours of pumping

WELL DATA

Well Depth	Casing Diameter (In.)	Casing Length (Ft.)
125	4	115
Type of Casing	**Hole Depth**	**Depth to Static Water Level**
PVC	125	64

TYPE OF COMPLETION: (Circle One or More): Gravel Packed, Underreamed, Telescoped, Natural Development, Open Hole, Other (Describe)

WELL GROUTED TO A DEPTH OF 10 FEET
Type Grout (circle one): Cement, Bentonite, or Mix

LOG DATA

TYPE OF LOG RUN (Circle One): No Log Run, Electric, Gamma Ray, Density, Sonic, Neutron, Other (Describe)

Name of Organization Running Log

GEOLOGIC DATA (Office Use Only)

Surface Elev.	Geologic Unit	Unit Thickness	Depth to Top
Subs. SWL	Date	Analysis	Aquifer Test

Driller's Remarks

SCREEN DATA

Diameter - Inches	Length - Feet	Slot Size - Inches
4	10	.014
Screen Type		**Depth to Bottom - Feet**
PVC		125

DESCRIPTION OF FORMATIONS ENCOUNTERED	FROM	TO
Red Clay	0	20
Red Sand	20	110
Coarse Sand & gravel	110	125

FORMATIONS (Continued) FROM TO

RECEIVED
DEC 07 1992
Dept. of Environmental Quality
Bureau of Land & Water Resources

IF MORE SPACE IS NEEDED, USE BACK

If well telescopes please
sketch and show depths.

GROUND LEVEL

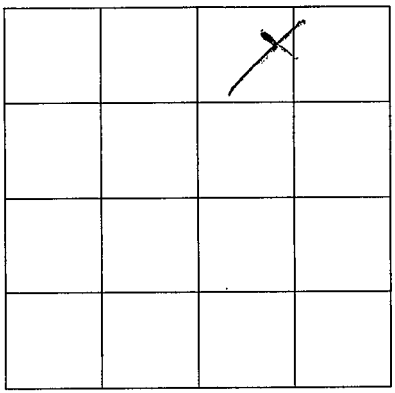

SECTION 30

Please indicate well location X.

ADDITIONAL INFORMATION

If more than one screen,
show location of each on sketch.