MISSISSIPPI DEPARTMENT OF ENVIRONMENTAL QUALITY
Bureau of Land and Water Resources

P. O. Box 10631
Jackson, MS 39289-0631
WATER WELL DRILLERS LOG

COUNTY WELL LOCATED	Pike
WELL NUMBER	D
CODED	
PERMIT NUMBER	
NAME OF DRILLING FIRM	Grenn water well & Supply
DATE WELL COMPLETED	4-1-94

NAME & MAILING ADDRESS OF LANDOWNER
Robert Grenn
1107 S. Peters, Apt. 519
New Orleans La

WELL LOCATION: SEC 27 TOWNSHIP 3 (N) S RANGE 7 (E) W

DISTANCE 2 1/2 Miles DIRECTION South of NEAREST TOWN McComb

OTHER LANDMARK

WELL PURPOSE: (Home) Irrigation, Municipal, Industrial, Fish Pond, etc.

PUMP DATA

PUMP TYPE (Circle One): (Submersible) Turbine, Jet Flowing Well, Other (Describe)

POWER TYPE (Circle One): (Electric) Tractor, Diesel, Gasoline, Butane, Other (Describe) H/P 1

Pump Capacity (GPM)	No. of Stages	Setting Depth
16	10	100 FT.

PUMP TEST

Well yielded 16 GPM with a drawdown of 0 ft. after 1 hours of pumping

WELL DATA

Well Depth	Casing Diameter (In.)	Casing Length (Ft.)
120	4 in.	110
Type of Casing	**Hole Depth**	**Depth to Static Water Level**
PVC	128	65

TYPE OF COMPLETION: (Circle One or More): (Gravel Packed) Underreamed, Telescoped, Natural Development, Open Hole, Other (Describe)

Top of Lap Pipe or Reduction in Casing FEET

IF TELESCOPED OR MORE THAN ONE SCREEN: USE BACK PAGE

LOG DATA

TYPE OF LOG RUN (Circle One): (No Log Run) Electric, Gamma Ray, Density, Sonic, Neutron, Other (Describe)

Name of Organization Running Log

GEOLOGIC DATA (Office Use Only)

Surface Elev.	Geologic Unit	Unit Thickness	Depth to Top
Subs. SWL	Date	Analysis	Aquifer Test

Driller's Remarks

SCREEN DATA

Diameter - Inches	Length - Feet	Slot Size - Inches
4 in.	10 ft.	.010
Screen Type	**Depth to Bottom - Feet**	
PVC	128	

DESCRIPTION OF FORMATIONS ENCOUNTERED	FROM	TO
red clay	0	15
red sandy clay	15	22
sand & grave	22	128

FORMATIONS (Continued) FROM TO

RECEIVED
JUN 20 1994
Dept. of Environmental Quality
Office of Land & Water Resources

IF MORE SPACE IS NEEDED, USE BACK

If well telescopes please
sketch and show depths.

GROUND LEVEL

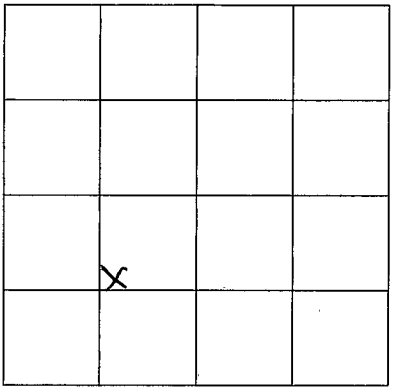

SECTION 27

Please indicate well location X.

ADDITIONAL INFORMATION

If more than one screen,
show location of each on sketch.