MISSISSIPPI DEPARTMENT OF ENVIRONMENTAL QUALITY
Office of Land and Water Resources

P. O. Box 10631
Jackson, MS 39289-0631
WATER WELL DRILLERS LOG

COUNTY WELL LOCATED	Pike
WELL NUMBER	D 2108
CODED	
PERMIT NUMBER	0-621
NAME OF DRILLING FIRM	Daniel Boone
DATE WELL COMPLETED	9-26-98
	Sandy Hook, MS

NAME & MAILING ADDRESS OF LANDOWNER
Theresa Martin
710 4th Street
McComb, MS

WELL LOCATION: SEC 12 TOWNSHIP 3 (N) S RANGE 7 (E) W

DISTANCE _____ Miles DIRECTION inside of NEAREST TOWN McComb

OTHER LANDMARK

WELL PURPOSE: (Home), Irrigation, Municipal, Industrial, Fish Pond, etc.

PUMP DATA

PUMP TYPE (Circle One):
Submersible, Turbine, Jet, Flowing Well, (Other) (Describe) Hand Pump

POWER TYPE (Circle One):
Electric, Tractor, Diesel, Gasoline, Butane, (Other) (Describe) Human H/P _____

Pump Capacity (GPM)	No. of Stages	Setting Depth
		FT.

PUMP TEST

Well yielded _____ GPM with

a drawdown of _____ ft.

after _____ hours of pumping

WELL DATA

Well Depth	Casing Diameter (In.)	Casing Length (Ft.)
85'	2"	75'

Type of Casing	Hole Depth	Depth to Static Water Level
PVC	85	50'

TYPE OF COMPLETION: (Circle One or More):
(Gravel Packed), Underreamed, Telescoped, Natural Development, Open Hole, Other (Describe) _____

WELL GROUTED TO A DEPTH OF 9 FEET
Type Grout (circle one): (Cement), Bentonite, or Mix

LOG DATA

TYPE OF LOG RUN (Circle One): (No Log Run), Electric, Gamma Ray, Density, Sonic, Neutron, Other (Describe) _____

Name of Organization Running Log

GEOLOGIC DATA (Office Use Only)

Surface Elev.	Geologic Unit	Unit Thickness	Depth to Top
Subs. SWL	Date	Analysis	Aquifer Test

Driller's Remarks

SCREEN DATA

Diameter - Inches	Length - Feet	Slot Size - Inches
2"	10'	.008

Screen Type	Depth to Bottom - Feet
PVC Sch 40	0'

Top of Lap Pipe or Reduction in Casing
FEET — IF TELESCOPED OR MORE THAN ONE SCREEN: USE BACK PAGE

DESCRIPTION OF FORMATIONS ENCOUNTERED	FROM	TO
Clay	0	35
Sand	35	52
Clay	52	55
Sand	55	85

FORMATIONS (Continued)	FROM	TO

IF MORE SPACE IS NEEDED, USE BACK

RECEIVED
DEC 21 1998
Dept. of Environmental Quality
Office of Land & Water Resources

If well telescopes please
sketch and show depths.

GROUND LEVEL

 

If more than one screen,
show location of each on sketch.

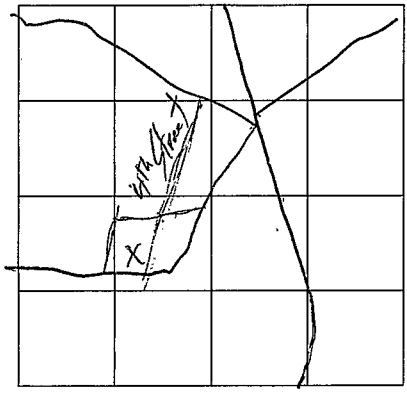

SECTION 12

Please indicate well location X.

ADDITIONAL INFORMATION