MISSISSIPPI DEPARTMENT OF ENVIRONMENTAL QUALITY
Office of Land and Water Resources

P. O. Box 10631
Jackson, MS 39289-0631
WATER WELL DRILLERS LOG

COUNTY WELL LOCATED	Pike
WELL NUMBER	D-2194
CODED	
DATE WELL COMPLETED	4-17-00
PERMIT NUMBER	0-6271
NAME OF DRILLING FIRM	Daniel Boone

NAME & MAILING ADDRESS OF LANDOWNER
Kanji Ashokbhai
Holden Rd.
McComb MS

WELL LOCATION SEC	TOWNSHIP	RANGE
23	3 (N) S	7 (E) W

DISTANCE	DIRECTION	NEAREST TOWN
1 Miles	S of	McComb

OTHER LANDMARK: McComb Sewage Treatment Pond

WELL PURPOSE: Home, Irrigation, Municipal, Industrial, Fish Pond, etc.

PUMP DATA

PUMP TYPE (Circle One): Submersible, Turbine, Jet, Flowing Well, Other (Describe)

POWER TYPE (Circle One): Electric, Tractor, Diesel, Gasoline, Butane, Other (Describe) H/P 2 HP

Pump Capacity (GPM)	No. of Stages	Setting Depth
50		100' FT.

PUMP TEST

Well yielded 90 GPM with a drawdown of 60 ft. after 20 hours of pumping

WELL DATA

Well Depth	Casing Diameter (In.)	Casing Length (Ft.)
200	4"	170

Type of Casing	Hole Depth	Depth to Static Water Level
PVC	200	5'

TYPE OF COMPLETION: (Circle One or More): Gravel Packed, Underreamed, Telescoped, Natural Development, Open Hole, Other (Describe)

WELL GROUTED TO A DEPTH OF 10 FEET
Type Grout (circle one): Cement, Bentonite, or Mix

LOG DATA

TYPE OF LOG RUN (Circle One): No Log Run, Electric, Gamma Ray, Density, Sonic, Neutron, Other (Describe)

Name of Organization Running Log

GEOLOGIC DATA (Office Use Only)

Surface Elev.	Geologic Unit	Unit Thickness	Depth to Top
Subs. SWL	Date	Analysis	Aquifer Test

Driller's Remarks

SCREEN DATA

Diameter - Inches	Length - Feet	Slot Size - Inches
4"	30'	.008

Screen Type	Depth to Bottom - Feet
PVC Sch.40	0

Top of Lap Pipe or Reduction in Casing
FEET

IF TELESCOPED OR MORE THAN ONE SCREEN USE BACK PAGE

DESCRIPTION OF FORMATIONS ENCOUNTERED	FROM	TO	FORMATIONS (Continued)	FROM	TO

IF MORE SPACE IS NEEDED, USE BACK

AUG 0 7 2000
Dept. of Environmental Quality
Office of Land & Water Resources

If well telescopes please
sketch and show depths.

GROUND LEVEL

If more than one screen,
show location of each on sketch.

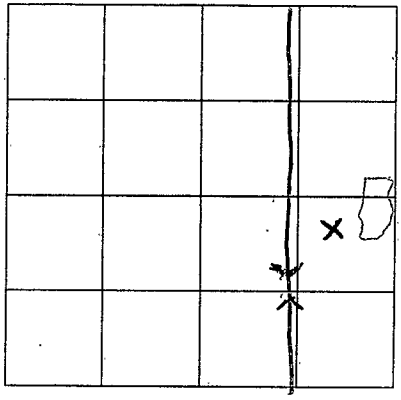

SECTION 23

Please indicate well location X.

ADDITIONAL INFORMATION