MISSISSIPPI DEPARTMENT OF ENVIRONMENTAL QUALITY
Office of Land and Water Resources

P. O. Box 10631
Jackson, MS 39289-0631
WATER WELL DRILLERS LOG

COUNTY WELL LOCATED: Pike	
WELL NUMBER: E 2123	CODED:
DATE WELL COMPLETED: 3-7-00	
PERMIT NUMBER:	
NAME OF DRILLING FIRM: Fitzgerald Well Service	

NAME & MAILING ADDRESS OF LANDOWNER
Elena Hagesatta.
Turner Rd. McComb MS.

WELL LOCATION: SEC 26 TOWNSHIP 3 (N) S RANGE 8 (E) W

DISTANCE 6 Miles DIRECTION East of NEAREST TOWN McComb

OTHER LANDMARK

WELL PURPOSE: Home, Irrigation, Municipal, Industrial, Fish Pond, etc.

PUMP DATA

PUMP TYPE (Circle One): Submersible, Turbine, Jet Flowing Well, Other (Describe) _____

POWER TYPE (Circle One): Electric, Tractor, Diesel, Gasoline, Butane, Other (Describe) _____ H/P 3/4

Pump Capacity (GPM)	No. of Stages	Setting Depth
12	12	150' FT.

PUMP TEST

Well yielded _____ GPM with

a drawdown of _____ ft.

after _____ hours of pumping

WELL DATA

Well Depth	Casing Diameter (In.)	Casing Length (Ft.)
160'	4"	140'

Type of Casing	Hole Depth	Depth to Static Water Level
PVC	160'	112'

TYPE OF COMPLETION: (Circle One or More): Gravel Packed, Underreamed, Telescoped, Natural Development, Open Hole, Other (Describe) _____

WELL GROUTED TO A DEPTH OF 10 FEET
Type Grout (circle one): Cement, Bentonite, or Mix

LOG DATA

TYPE OF LOG RUN (Circle One): No Log Run, Electric, Gamma Ray, Density, Sonic, Neutron, Other (Describe) _____

Name of Organization Running Log

GEOLOGIC DATA (Office Use Only)

Surface Elev.	Geologic Unit	Unit Thickness	Depth to Top
Subs. SWL	Date	Analysis	Aquifer Test

Driller's Remarks

Top of Lap Pipe or Reduction in Casing
FEET — IF TELESCOPED OR MORE THAN ONE SCREEN: USE BACK PAGE

SCREEN DATA

Diameter - Inches	Length - Feet	Slot Size - Inches
4"	20	012.

Screen Type	Depth to Bottom - Feet
PVC	160'

DESCRIPTION OF FORMATIONS ENCOUNTERED	FROM	TO
clay	0	40
sand	40	80
clay	80	100
sand	100	140
Course sand	140	160

FORMATIONS (Continued)	FROM	TO

REC'D JUN 21 2001

IF MORE SPACE IS NEEDED, USE BACK

If well telescopes please
sketch and show depths.

GROUND LEVEL

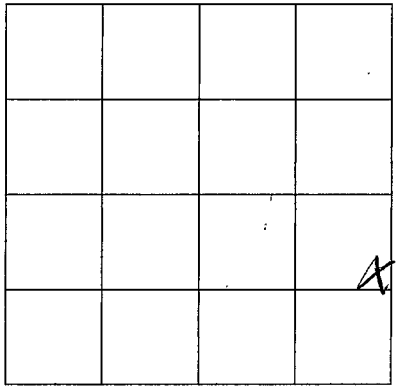

SECTION _____

Please indicate well location X.

ADDITIONAL INFORMATION

If more than one screen,
show location of each on sketch.