

G 22  
9-3-64

WATER WELL DRILLERS LOG

**CODED**

Date: 9-3, 1964, Driller: Chester Reeves County Pike  
(Name)

(1) Owner of Land: Geo. Mullendore  
(Name)  
Mapahia  
(Address)

(2) Location:  $\frac{1}{4}$ ,  $\frac{1}{4}$ , Sec. 15 2 7  
1 miles west of Mapahia  
(distance) (direction) (Nearest Town)

(3) Topography: Hilly  
(Hilly) (Flat) (Level)

(4) Purpose of Well: Domestic  
(Domestic Irrigation, Municipal, Industrial, Other)

| Description & Color of Materials<br>Sand, Clay, Red Clay, Shell, etc. | Thick-<br>ness<br>Feet | Depth<br>Feet |
|---|------------------------|---------------|
| <u>Red clay</u>   | <u>20</u>              | <u>20</u>     |
| <u>Red sand</u>   | <u>30</u>              | <u>50</u>     |
| <u>Red clay</u>   |                        |               |
| <u>Sand &amp; gravel</u>  | <u>50</u>              | <u>100</u>    |
| <u>Sand &amp; gravel</u>  | <u>20</u>              | <u>120</u>    |

Information upon completion of well:

(1) Diameter 2 inches.

(2) Total Depth 120 feet.

(3) Water Level 70 feet below top of ground.

(4) Cased to bottom size 4"

(5) Screen: Size 1/4", Length 7'


(6) Were any formations sealed against pollution?  
\_\_\_\_\_ yes,  no.

**CODED**

If YES depth of formation \_\_\_\_\_

Why \_\_\_\_\_

Driller's Remarks: all well  
dry -

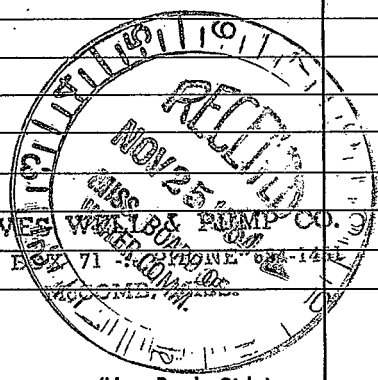

Well No.

(Use Back Side)






