PIKE
G 120
7-26-74

MISSISSIPPI
BOARD OF WATER COMMISSIONERS
416 North State Street
Jackson, Mississippi 39201

CODED

WATER WELL DRILLERS LOG

26 July 1974 — date well completed
J. T. Carrington — firm name
Pike — county well located

LANDOWNER: Dr. Beacham
Magnolia
(mailing address)

WELL LOCATION:
sec. 23 T 2 N R 7 E
2 miles S of Mag
(distance) (direction) (nearest town)

WELL PURPOSE: (home, irrigation, municipal, industrial)

WELL COMPLETION DATA:
(1) diameter (inches) 4
(2) total depth (feet) 230
(3) static water level (feet) [redacted] above top of ground
(4) casing PVC (material), 209 (depth),
(size) if telescope see back.
(5) screen 21 (length), 209 (depth to top)
4 (size), PVC (material)
(6) pump (HP) 70 (yield gpm)
(type power)
(7) electric log (yes or no)
(organization running log)
(8) how well bottom plugged

DRILLERS REMARKS: Flowwell

description of formations encountered	from	to
Clay	0	15
Sand	15	45
Sand	45	70
Clay	70	95
Sand	95	230

RECEIVED
AUG 21 1974
MISS. BD. OF WATER COMM.

If well telescopes please sketch and show depths.

GROUND LEVEL

If more than one screen, show locations of each on sketch.

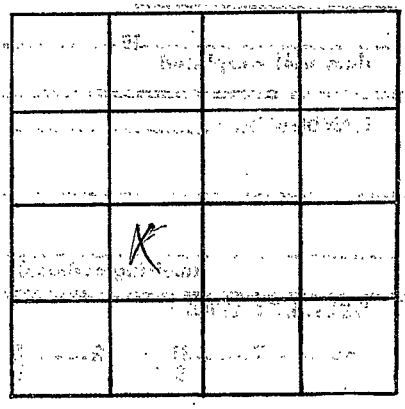

SECTION 23

Please indicate well location X.

ADDITIONAL INFORMATION