Pike
H 49
4-2-69

MISSISSIPPI
BOARD OF WATER COMMISSIONERS
416 North State Street
Jackson, Mississippi 39201

WATER WELL DRILLERS LOG

2 April 1969 — J. T. Covington & Son — Pike
date well completed — firm name — county well located

LANDOWNER: Mallard Maple
Magnolia, Miss.
(mailing address)

WELL LOCATION:
sec. 8 T 2 N R 8 E

3 (distance) miles East (direction) of Magnolia (nearest town)

WELL PURPOSE: Home
(home, irrigation, municipal, industrial)

WELL COMPLETION DATA:

(1) diameter (inches) 4
(2) total depth (feet) 115
(3) static water level (feet) 20 below ~~above~~ top of ground.
(4) casing Plastic (material); 109 (depth),
4 (size) if telescope see back.
(5) screen 6 (length), (depth to top)
4 (size), Plastic (material)
(6) pump 5 (HP) 500 (yield gpm)
Elec. (type power)
(7) electric log (yes or no)
(organization running log)
(8) how well bottom plugged wood

DRILLERS REMARKS:

description of formations encountered	from	to
Clay	0	15
Sand & Clay	16	60
Chalk	60	85
Sand & Rock	85	100
Sand	100	115

APR 4 - 1969
MISS. BD. OF WATER COMM.

If well telescopes please sketch and show depths.

GROUND LEVEL

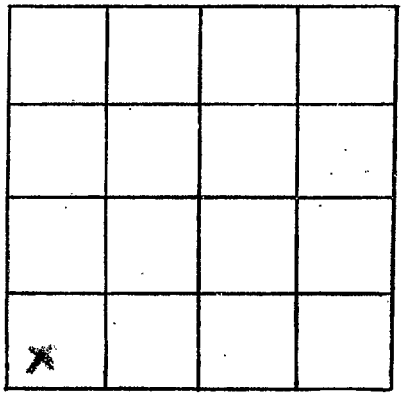

SECTION 8

Please indicate well location X.

ADDITIONAL INFORMATION

If more than one screen, show locations of each on sketch.