PIKE

H 2010

10-16-78

MISSISSIPPI
BOARD OF WATER COMMISSIONERS
416 North State Street
Jackson, Mississippi 39201

WATER WELL DRILLERS LOG

10-16 19 78 Fitzgerald Well Serv Pike
date well completed — firm name — county well located

LANDOWNER: Leon Loudin

R.R. Magnolia
(mailing address)

WELL LOCATION:
sec. 28 T 2 N/S R 8 E/W

6 miles (distance) E (direction) of Magnolia (nearest town)

WELL PURPOSE: Home
(home, irrigation, municipal, industrial)

WELL COMPLETION DATA:

(1) diameter (inches) 4

(2) total depth (feet) 140

(3) static water level (feet) 85 below/above top of ground.

(4) casing PVC (material), 132 (depth),
4 (size) if telescope see back.

(5) screen 8 (length), 132 (depth to top)
4 (size), PVC (material)

(6) pump 1/2 (HP) 10 (yield gpm)
Elec (type power)

(7) electric log no (yes or no)
(organization running log)

(8) how well bottom plugged Sand Plug

DRILLERS REMARKS:

description of formations encountered	from	to
Red clay	0	20
Red sand	20	110
Coarse sand & gravel	110	140

RECEIVED
DEC 1 1978
MISS. BD. OF WATER COMM.

If well telescopes please sketch and show depths.

GROUND LEVEL

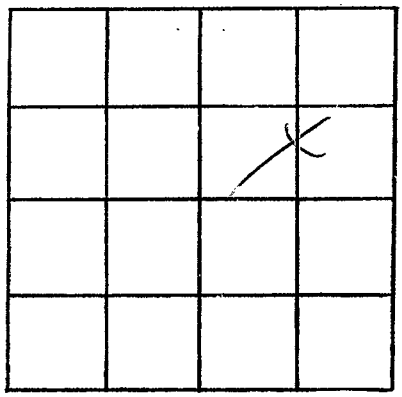

SECTION 28

Please indicate well location X.

ADDITIONAL INFORMATION

If more than one screen, show locations of each on sketch.