MISSISSIPPI DEPARTMENT OF ENVIRONMENTAL QUALITY
Office of Land and Water Resources

P. O. Box 10631
Jackson, MS 39289-0631

WATER WELL DRILLERS LOG

COUNTY WELL LOCATED: Pike
WELL NUMBER: H 2017 CODED
DATE WELL COMPLETED: 3-16-99
PERMIT NUMBER:
NAME OF DRILLING FIRM: Fitzgerald Well

NAME & MAILING ADDRESS OF LANDOWNER
Pat Miller
Tangelwood Rd. Magnolia

WELL LOCATION: SEC 3 TOWNSHIP 2 (N) S RANGE 8 (E) W
DISTANCE 7 Miles DIRECTION East of NEAREST TOWN Magnolia
OTHER LANDMARK
WELL PURPOSE (Home), Irrigation, Municipal, Industrial, Fish Pond, etc.

PUMP DATA

PUMP TYPE (Circle One): (Submersible), Turbine, Jet, Flowing Well, Other (Describe)
POWER TYPE (Circle One): (Electric), Tractor, Diesel, Gasoline, Butane, Other (Describe) H/P 1/2

Pump Capacity (GPM)	No. of Stages	Setting Depth
12	9	120 FT.

PUMP TEST
Well yielded _____ GPM with a drawdown of _____ ft. after _____ hours of pumping

WELL DATA

Well Depth	Casing Diameter (In.)	Casing Length (Ft.)
199	4"	189'

Type of Casing	Hole Depth	Depth to Static Water Level
PVC	199'	87'

TYPE OF COMPLETION: (Circle One or More): (Gravel Packed), Underreamed, Telescoped, Natural Development, Open Hole, Other (Describe)

WELL GROUTED TO A DEPTH OF 10 FEET
Type Grout (circle one): Cement, Bentonite, or (Mix)

LOG DATA

TYPE OF LOG RUN (Circle One): (No Log Run), Electric, Gamma Ray, Density, Sonic, Neutron, Other (Describe)
Name of Organization Running Log

SCREEN DATA

Diameter - Inches	Length - Feet	Slot Size - Inches
4"	10	.012

Screen Type	Depth to Bottom - Feet
PVC	199'

GEOLOGIC DATA (Office Use Only)

Surface Elev.	Geologic Unit	Unit Thickness	Depth to Top
Subs. SWL	Date	Analysis	Aquifer Test

Driller's Remarks

Top of Lap Pipe or Reduction in Casing FEET
IF TELESCOPED OR MORE THAN ONE SCREEN: USE BACK PAGE

DESCRIPTION OF FORMATIONS ENCOUNTERED	FROM	TO
Top Soil	0	5
Clay	5	40
Sand	40	60
Gravel	60	80
Clay	80	100
Sand	100	120
Clay	120	160
Sand	160	180
Coursesand	180	189

FORMATIONS (Continued)	FROM	TO

RECEIVED
MAY 26 1999
Dept of Environmental Quality
Office of Land & Water Resources

IF MORE SPACE IS NEEDED, USE BACK

If well telescopes please sketch and show depths.

GROUND LEVEL

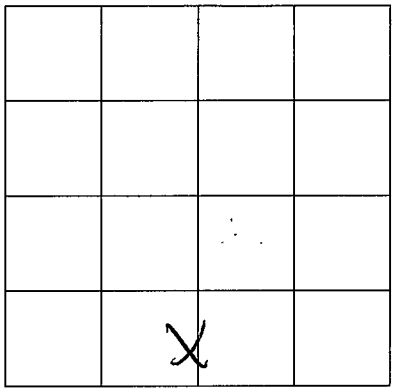

SECTION _____

Please indicate well location X.

ADDITIONAL INFORMATION

If more than one screen, show location of each on sketch.