Pike
J 60
9-1-72

MISSISSIPPI
BOARD OF WATER COMMISSIONERS
416 North State Street
Jackson, Mississippi 39201

WATER WELL DRILLERS LOG

CODED

Sept 1 19 72 Fitzwell Well Co Pike
date well completed — firm name — county well located

LANDOWNER: Lenora Barnes
Rt 1 Magnolia Miss
(mailing address)

WELL LOCATION:
sec. 20 T 2 (N/S) R 9 (E/W)
8 miles (distance) E (direction) of McComb (nearest town)

WELL PURPOSE: Home
(home, irrigation, municipal, industrial)

WELL COMPLETION DATA:
(1) diameter (inches) 4
(2) total depth (feet) 143
(3) static water level (feet) 95 below / above top of ground.
(4) casing Plastic (material), 135 (depth), 4 (size) if telescope see back.
(5) screen 8 (length), 135 (depth to top), 4 (size), Plastic (material)
(6) pump 1/2 (HP) 10 (yield gpm)
Elec (type power)
(7) electric log No (yes or no)
(organization running log)
(8) how well bottom plugged Wooden Plug

DRILLERS REMARKS:

description of formations encountered	from	to
Red Clay	0	20
Red Gravel	20	80
Red Sand	80	130
Coarse Salt & gravel	130	143

CODED

7 1972
Miss. Bd. of Water Comm.

If well telescopes please sketch and show depths.

GROUND LEVEL

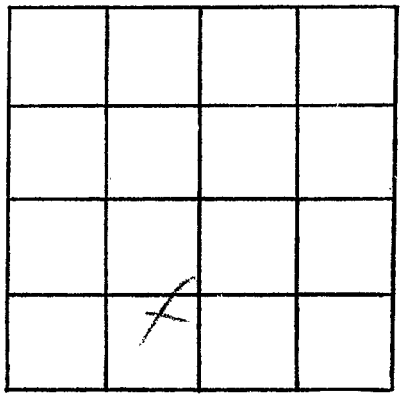

SECTION 20

Please indicate well location X.

ADDITIONAL INFORMATION

If more than one screen, show locations of each on sketch.