Pike
J 2018
8-30-77

MISSISSIPPI
BOARD OF WATER COMMISSIONERS
416 North State Street
Jackson, Mississippi 39201

WATER WELL DRILLERS LOG

8-30 (date well completed) 19 77 Fitzgerald Well Serv (firm name) Pike (county well located)

LANDOWNER: Dewitt Conney

R.R. McComb (mailing address)

WELL LOCATION:

sec. 4 T 2 (N/S) R 9 (E/W)

10 (distance) miles SE (direction) of McComb (nearest town)

WELL PURPOSE: Home (home, irrigation, municipal, industrial)

WELL COMPLETION DATA:

(1) diameter (inches) 4

(2) total depth (feet) 215

(3) static water level (feet) 95 below ~~above~~ top of ground.

(4) casing PVC (material), 207 (depth), 4 (size) if telescope see back.

(5) screen 8 (length), 207 (depth to top), 4 (size), PVC (material)

(6) pump 1/2 (HP) 10 (yield gpm) Elec (type power)

(7) electric log No (yes or no) _____ (organization running log)

(8) how well bottom plugged Sand Slurr

DRILLERS REMARKS:

description of formations encountered	from	to
Red Clay	0	20
Red Sand	0	70
White & Blue Chalk	70	190
Fine Sand	190	200
Coarse Sand & gravel	200	215

RECEIVED
OCT 31 1977
MISS. BD. OF WATER COMM.

If well telescopes please sketch and show depths.

GROUND LEVEL

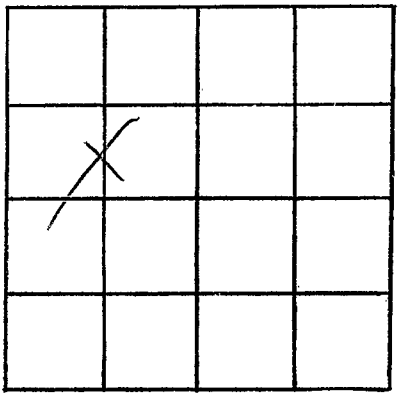

SECTION 4

Please indicate well location X.

ADDITIONAL INFORMATION

If more than one screen, show locations of each on sketch.