PIKE
J
2075

MISSISSIPPI DEPARTMENT OF NATURAL RESOURCES

Bureau of Land and Water Resources
Southport Mall
P.O. Box 10631
Jackson, Mississippi 39209

WATER WELL DRILLERS LOG

5-5- 1986 Fitzgerald Well Serv Pike
date well completed firm name county well located

LANDOWNER: Joyce Allmond
RR. 2, McComb, Miss.
(mailing address)

WELL LOCATION:
sec. 8 T 2 N/S R 9 E/W
8 miles E of McComb
(distance) (direction) (nearest town)

WELL PURPOSE: Home
(home, irrigation, municipal, industrial)

WELL COMPLETION DATA:

(1) diameter (inches) 4
(2) total depth (feet) 130
(3) static water level (feet) 95 below/above top of ground.
(4) casing PVC (material), 122 (depth), 4 (size) If telescope see back.
(5) screen 8 (length), 122 (depth to top), 4 (size), PVC (material)
(6) pump 1/2 (HP) 10 (yield gpm) Elec (type power)
(7) electric log no (yes or no)
(organization running log)
(8) how well bottom plugged Sand Shut

DRILLERS REMARKS:

description of formations encountered	from	to
Red clay	0	20
Red Sand	20	120
Coarse Sand & gravel	120	130

RECEIVED
MAY 28 1986
Department of Natural Resources
Bureau of Land & Water Resources

If well telescopes please sketch and show depths.

GROUND LEVEL

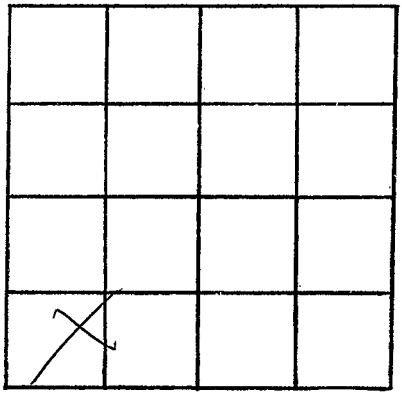

SECTION 8

Please indicate well location X.

ADDITIONAL INFORMATION

If more than one screen, show locations of each on sketch.