MISSISSIPPI DEPARTMENT OF ENVIRONMENTAL QUALITY
Office of Land and Water Resources

P. O. Box 10631
Jackson, MS 39289-0631
WATER WELL DRILLERS LOG

COUNTY WELL LOCATED: Pike	
WELL NUMBER: J	CODED:
PERMIT NUMBER:	
NAME OF DRILLING FIRM: FITZGERALD Well Serv	
DATE WELL COMPLETED: Aug 7-93	

NAME & MAILING ADDRESS OF LANDOWNER
Andrew Gatlin
RR 2 McComb, MS

WELL LOCATION: SEC 9 TOWNSHIP 2 N/S RANGE 9 E/W

DISTANCE 3 Miles DIRECTION S of NEAREST TOWN Holmesville

OTHER LANDMARK

WELL PURPOSE: Home, Irrigation, Municipal, Industrial, Fish Pond, etc.
Home

PUMP DATA

PUMP TYPE (Circle One): Submersible, Turbine, Jet, Flowing Well, Other (Describe)

POWER TYPE (Circle One): Electric, Tractor, Diesel, Gasoline, Butane, Other (Describe) H/P 12

Pump Capacity (GPM)	No. of Stages	Setting Depth
10	8	120 FT.

PUMP TEST

Well yielded 25 GPM with a drawdown of 2 ft. after 2 hours of pumping

WELL DATA

Well Depth	Casing Diameter (In.)	Casing Length (Ft.)
190	4	180

Type of Casing	Hole Depth	Depth to Static Water Level
PVC	190	95

TYPE OF COMPLETION: (Circle One or More): Gravel Packed, Underreamed, Telescoped, Natural Development, Open Hole, Other (Describe)

WELL GROUTED TO A DEPTH OF 10 FEET
Type Grout (circle one): Cement, Bentonite, or Mix

LOG DATA

TYPE OF LOG RUN (Circle One): No Log Run, Electric, Gamma Ray, Density, Sonic, Neutron, Other (Describe)

Name of Organization Running Log

GEOLOGIC DATA (Office Use Only)

Surface Elev.	Geologic Unit	Unit Thickness	Depth to Top
Subs. SWL	Date	Analysis	Aquifer Test

Driller's Remarks

SCREEN DATA

Diameter - Inches	Length - Feet	Slot Size - Inches
4	10	10/4

Screen Type	Depth to Bottom - Feet
PVC	190

DESCRIPTION OF FORMATIONS ENCOUNTERED	FROM	TO	FORMATIONS (Continued)	FROM	TO
Red Clay	0	20			
Red Sand	20	70			
white blue chalk	70	155			
Course Sand	155	190			
			IF MORE SPACE IS NEEDED, USE BACK		

RECEIVED
OCT 18 1993
Dept. of Environmental Quality
Office of Land & Water Resources

If well telescopes please
sketch and show depths.

GROUND LEVEL

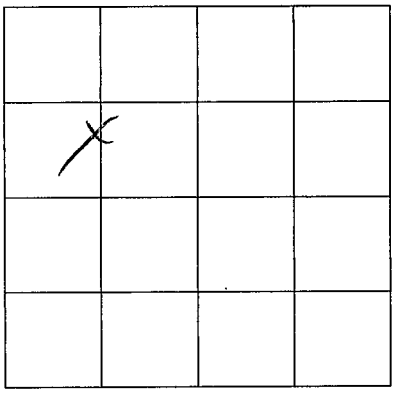

SECTION 9

Please indicate well location X.

ADDITIONAL INFORMATION

If more than one screen,
show location of each on sketch.