MISSISSIPPI DEPARTMENT OF ENVIRONMENTAL QUALITY
Office of Land and Water Resources

P. O. Box 10631
Jackson, MS 39289-0631
WATER WELL DRILLERS LOG

COUNTY WELL LOCATED: PIKE	
WELL NUMBER: I 2128	CODED
PERMIT NUMBER: 0-287	
NAME OF DRILLING FIRM: Reeves Well Ser	
DATE WELL COMPLETED: 1-29-98	

NAME & MAILING ADDRESS OF LANDOWNER: Virgo Crossing, Hwy 98-E.

WELL LOCATION: SEC 2 TOWNSHIP 2 (N) S RANGE 9 (E) W

DISTANCE 15 Miles DIRECTION E of NEAREST TOWN McComb

OTHER LANDMARK:

WELL PURPOSE: Home, Irrigation, Municipal, Industrial, Fish Pond, etc.: ~~Home~~ Store

PUMP DATA

PUMP TYPE (Circle One): (Submersible) Turbine, Jet Flowing Well, Other (Describe)

POWER TYPE (Circle One): (Electric) Tractor, Diesel, Gasoline, Butane, Other (Describe) H/P 1/2

Pump Capacity (GPM)	No. of Stages	Setting Depth
10	8	40 FT.

PUMP TEST: Well yielded 100 GPM with a drawdown of 0 ft. after 1 hours of pumping

WELL DATA

Well Depth	Casing Diameter (In.)	Casing Length (Ft.)
110'	4"	20'
Type of Casing	**Hole Depth**	**Depth to Static Water Level**
PVC	110'	2'

TYPE OF COMPLETION: (Circle One or More): Gravel Packed, Underreamed, Telescoped, Natural Development, Open Hole, Other (Describe) 10 gal sand

WELL GROUTED TO A DEPTH OF 10 FEET
Type Grout (circle one): (Cement) Bentonite, or Mix

LOG DATA

TYPE OF LOG RUN (Circle One): No Log Run, Electric, Gamma Ray, Density, Sonic, Neutron, Other (Describe)

Name of Organization Running Log

GEOLOGIC DATA (Office Use Only)

Surface Elev.	Geologic Unit	Unit Thickness	Depth to Top
Subs. SWL	Date	Analysis	Aquifer Test

Driller's Remarks

SCREEN DATA

Diameter - Inches	Length - Feet	Slot Size - Inches
4"	10'	10 Thds.
Screen Type	**Depth to Bottom - Feet**	
PVC	110'	

Top of Lap Pipe or Reduction in Casing FEET

IF TELESCOPED OR MORE THAN ONE SCREEN: USE BACK PAGE

DESCRIPTION OF FORMATIONS ENCOUNTERED	FROM	TO
clay	0	20
sand & gravel	20	60
Chalk	60	90
sand & pea gravel	90	110

FORMATIONS (Continued)	FROM	TO

06-23-98A09:38 RCVD

IF MORE SPACE IS NEEDED, USE BACK

If well telescopes please
sketch and show depths.

GROUND LEVEL

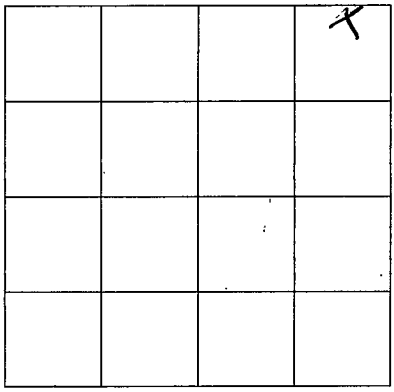

SECTION 2

Please indicate well location X.

ADDITIONAL INFORMATION

If more than one screen,
show location of each on sketch.