MISSISSIPPI DEPARTMENT OF ENVIRONMENTAL QUALITY
Office of Land and Water Resources

P. O. Box 10631
Jackson, MS 39289-0631
WATER WELL DRILLERS LOG

COUNTY WELL LOCATED: PIKE	
WELL NUMBER: K-2139	CODED:
PERMIT NUMBER: 0-287	
NAME OF DRILLING FIRM: REEVES WELL SER.	
DATE WELL COMPLETED: 6-14-99	

NAME & MAILING ADDRESS OF LANDOWNER
CURTIS HOLLOWAY
2017 CARTER Rd
OSYKA MISS.

WELL LOCATION: SEC 20 TOWNSHIP 1 (N/S) RANGE 7 (E/W)

DISTANCE 3 Miles DIRECTION WNW of NEAREST TOWN OSYKA

OTHER LANDMARK

WELL PURPOSE: Home, Irrigation, Municipal, Industrial, Fish Pond, etc.

PUMP DATA

PUMP TYPE (Circle One): Submersible, Turbine, Jet, Flowing Well, Other (Describe)

POWER TYPE (Circle One): Electric, Tractor, Diesel, Gasoline, Butane, Other (Describe) H/P 1/2

Pump Capacity (GPM)	No. of Stages	Setting Depth
10	8	120 FT.

PUMP TEST
Well yielded 50 GPM with a drawdown of 0 ft. after 1 hours of pumping

WELL DATA

Well Depth	Casing Diameter (In.)	Casing Length (Ft.)
142'	4"	20'
Type of Casing	**Hole Depth**	**Depth to Static Water Level**
PVC	142'	90'

TYPE OF COMPLETION: (Circle One or More): Gravel Packed, Underreamed, Telescoped, Natural Development, Open Hole, Other (Describe) 10 GAL. SAND

WELL GROUTED TO A DEPTH OF 10 FEET
Type Grout (circle one): Cement, Bentonite, or Mix

LOG DATA

TYPE OF LOG RUN (Circle One): No Log Run, Electric, Gamma Ray, Density, Sonic, Neutron, Other (Describe)

Name of Organization Running Log

GEOLOGIC DATA (Office Use Only)

Surface Elev.	Geologic Unit	Unit Thickness	Depth to Top
Subs. SWL	Date	Analysis	Aquifer Test

Driller's Remarks

REC'D JAN 03 2002

SCREEN DATA

Diameter - Inches	Length - Feet	Slot Size - Inches
4"	10'	10 SLOT
Screen Type		**Depth to Bottom - Feet**
PVC		142'

Top of Lap Pipe or Reduction in Casing FEET

IF TELESCOPED OR MORE THAN ONE SCREEN: USE BACK PAGE

DESCRIPTION OF FORMATIONS ENCOUNTERED	FROM	TO	FORMATIONS (Continued)	FROM	TO
CLAY	0	18			
SAND	18	30			
SAND + PEA GRAVEL	30	90			
CHALK	90	120			
SAND + GRAVEL	120	142			
			IF MORE SPACE IS NEEDED, USE BACK		

If well telescopes please
sketch and show depths.

GROUND LEVEL

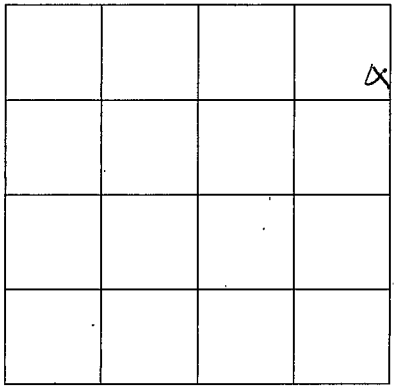

SECTION 20

Please indicate well location X.

ADDITIONAL INFORMATION

If more than one screen,
show location of each on sketch.