

PIKE
L2
8-28-62

CODED

WATER WELL DRILLERS LOG

Date: 8-28, 1962, Driller Chester Reeves County PIKE

(Name)

(1) Owner of Land: E.E. Brown
(Name)
RFD, Osyka
(Address)

(2) Location: 32nd St
5 miles EAST of Osyka
(distance) (direction) (Nearest Town)

(3) Topography: Hilly
(Hilly) (Flat) (Level)

(4) Purpose of Well: Domestic
(Domestic Irrigation
Municipal, Industrial, Other)

Description & Color of Materials Sand, Clay, Red Clay, Shell, etc.	Thick- ness Feet	Depth Feet
<u>Red Clay</u>	<u>22</u>	<u>22</u>
<u>Sand & gravel</u>	<u>18</u>	<u>40</u>
<u>Red chalk</u>	<u>5</u>	<u>45</u>
<u>Friable and yellow chalky</u>		
<u>Sand of white chalky</u>	<u>30</u>	<u>75</u>
<u>Red Red Sand</u>	<u>15</u>	<u>90</u>
<u>Coarse Sand</u>	<u>75</u>	<u>165</u>
	<u>14</u>	<u>179</u>

Information upon completion of well:

(1) Diameter 2 inches.


(2) Total Depth 179 feet.

(3) Water Level 80 feet below top of ground.

(4) Cased to Bottom Size

(5) Screen: Size 1 1/4 Length 6'

(6) Were any formations sealed against pollution?
 _____ yes, no.

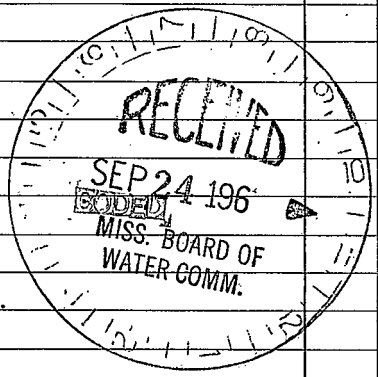

REEVES WELL AND PUMP CO.
Phone 1250
MCCOMB, MISSISSIPPI

If YES depth of formation _____

Why _____

Drillers Remarks: New house

Well No.

(Use Back Side)


