

PIKE

#L

MISSISSIPPI BOARD OF WATER COMMISSIONERS

CODED

5-13-66

CODED

WATER WELL DRILLERS LOG

Date: 5-13, 1966, Driller: Chester Reeves, County Pike

(1) Owner of Land: Frank Gentry
(Name)
RFD 1, Osyka,
(Address)

(2) Location: 1/4, 1/4, Sec. 18, T1R8,
8 miles S.E., of Mayraha,
(distance) (direction) (Nearest Town)

(3) Topography: Hilly
(Hilly) (Flat) (Level)

(4) Purpose of Well: Domestic
(Domestic Irrigation
Municipal, Industrial, Other)

Description & Color of Materials Sand, Clay, Red Clay, Shell, etc.	Thick- ness Feet	Depth Feet
<u>Red clay</u>	<u>18</u>	<u>18</u>
<u>Red sand and clay</u>	<u>32</u>	<u>50</u>
<u>Gravel sand</u>	<u>30</u>	<u>80</u>
<u>Chalk</u>	<u>5</u>	<u>85</u>
<u>Granite</u>	<u>13</u>	<u>98</u>

Information upon completion of well:

(1) Diameter 4 inches.

(2) Total Depth 98 feet.


(3) Water Level 70 feet below top of ground.

(4) Cased to bottom size 4"

(5) Screen: Size 4", Length 6'

(6) Were any formations sealed against pollution?
 yes, no.

Cannot locate. RM

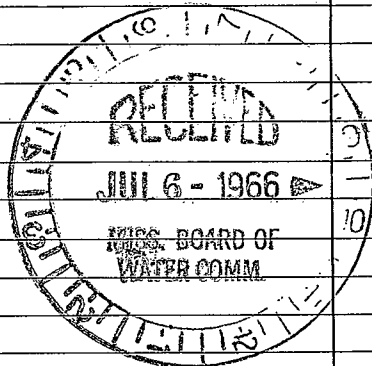

If YES depth of formation _____

Why _____

Drillers Remarks: red well bed

Yield in gpm: 10

Size pump: 3/4 H.P. Jet.

Type power: Electric

REEVES WELL & PUMP CO.
 P. O. BOX 71 -- PHONE 684-1452
 McCOMB, MISS.




