Pike
L 2062

MISSISSIPPI DEPARTMENT OF NATURAL RESOURCES

Bureau of Land and Water Resources
Southport Mall
P.O. Box 10631
Jackson, Mississippi 39209

WATER WELL DRILLERS LOG

12-18 1987 Fitzgerald Well Ser Pike
date well completed firm name county well located

LANDOWNER: Anthony Mills
R.R. 2, McComb, Miss.
(mailing address)

WELL LOCATION:
sec. 11 T 1 N/S R 8 E/W
1 miles SW of EMERALD
(distance) (direction) (nearest town)

WELL PURPOSE: Home
(home, irrigation, municipal, industrial)

WELL COMPLETION DATA:

(1) diameter (inches) 4
(2) total depth (feet) 140
(3) static water level (feet) 60 below/~~above~~ top of ground.
(4) casing PVC (material), 130 (depth),
4 (size) if telescope see back.
(5) screen 10 (length), 130 (depth to top)
4 (size), PVC (material)
(6) pump 1/2 (HP) 10 (yield gpm)
Elec (type power)
(7) electric log No (yes or no)
(organization running log)
(8) how well bottom plugged Sand Shale

DRILLERS REMARKS:

description of formations encountered	from	to
Red clay	0	20
Red gravel	20	60
White chalk	60	127
Coarse sand & gravel	127	140

RECEIVED
FEB 12 1987
Department of Natural Resources
Bureau of Land & Water Resources

If well telescopes please sketch and show depths.

GROUND LEVEL

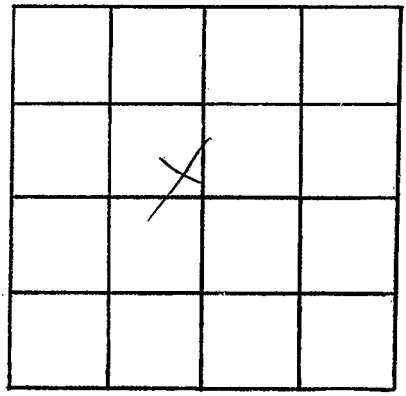

SECTION 11

Please indicate well location X.

ADDITIONAL INFORMATION

If more than one screen, show locations of each on sketch.