MISSISSIPPI DEPARTMENT OF NATURAL RESOURCES

Bureau of Land and Water Resources

P.O. Box 10631
Jackson, Mississippi 39209

WATER WELL DRILLERS LOG

COUNTY WELL LOCATED: Pike	
WELL NUMBER: L	CODED:
2072	
DATE WELL COMPLETED: 5-2-89	

PERMIT NUMBER
NAME OF DRILLING FIRM: FITZGERALD Well Serv

NAME & MAILING ADDRESS OF LANDOWNER

Margaret Connelly
A.R. Oxyfluor Inc.

WELL LOCATION: SEC 34 TOWNSHIP 1 N/S RANGE 8 E/W

DISTANCE 5 Miles DIRECTION E of NEAREST TOWN Oxyfluor

OTHER LANDMARK

WELL PURPOSE: Home, Irrigation, Municipal, Industrial, Fish Pond, etc.
Home

PUMP DATA

PUMP TYPE (Circle One): Submersible, Turbine, Jet, Flowing Well, Other (Describe)

POWER TYPE (Circle One): Electric, Tractor, Diesel, Gasoline, Butane, Other (Describe)

Pump Capacity (GPM)	No. of Stages	Setting Depth
10	9	95 FT.

PUMP TEST

Well yielded 15 GPM with a drawdown of 2 ft. after 2 hours of pumping

WELL DATA

Well Depth	Casing Diameter (In.)	Casing Length (Ft.)
105	4	95

Type of Casing	Hole Depth	Depth to Static Water Level
PVC	105	75

TYPE OF COMPLETION: (Circle One or More): Gravel Packed, Underreamed, Telescoped, Natural Development, Open Hole, Other (Describe)

Top of Lap Pipe or Reduction in Casing FEET

IF TELESCOPED OR MORE THAN ONE SCREEN: USE BACK PAGE

LOG DATA

TYPE OF LOG RUN (Circle One): No Log Run, Electric, Gamma Ray, Density, Sonic, Neutron, Other (Describe)

Name of Organization Running Log

GEOLOGIC DATA (Office Use Only)

Surface Elev.	Geologic Unit	Unit Thickness	Depth to Top
Subs. SWL	Date	Analysis	Aquifer Test

Driller's Remarks

SCREEN DATA

Diameter - Inches	Length - Feet	Slot Size - Inches
4	10	10/4

Screen Type	Depth to Bottom - Feet
PVC	105

DESCRIPTION OF FORMATIONS ENCOUNTERED	FROM	TO
Red Clay	0	20
Red Sand	20	90
Coarse sand & gravel	90	105

FORMATIONS (continued) FROM TO

IF MORE SPACE IS NEEDED, USE BACK

RECEIVED
JUN 8 1989
Department of Natural Resources
Bureau of Land & Water Resources

If well telescopes please
sketch and show depths.

GROUND LEVEL

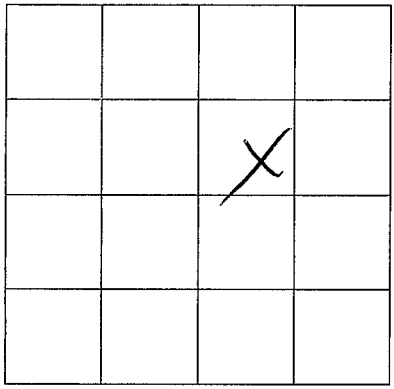

SECTION 34

Please indicate well location X.

ADDITIONAL INFORMATION

If more than one screen,
show location of each on sketch.